

Desoto
K 81
9-68

MISSISSIPPI
BOARD OF WATER COMMISSIONERS
416 North State Street
Jackson, Mississippi 39201 **CODED**

WATER WELL DRILLERS LOG

Sept 19 1968 Bumpax Well Co
date well completed firm name county well located

LANDOWNER: Edward Stapp
Rt 2 Hernando, Miss
(mailing address)


description of formations encountered	from	to
<u>Shamal Clay</u>	<u>0</u>	<u>70</u>
<u>Sen</u>	<u>70</u>	<u>178</u>

WELL LOCATION:
sec 5 T 3 N R 8 E
2 1/2 miles west of Hernando
(distance) (direction) (nearest town)

WELL PURPOSE:
(home, irrigation, municipal, industrial)

- WELL COMPLETION DATA:
- (1) diameter (Inches) 4"
 - (2) total depth (feet) 178
 - (3) static water level (feet) 110 ^{below} _{above} top of ground.
 - (4) casing 4" galv 178
(material) (depth)
4" If telescope see back.
(size)
 - (5) screen 7' 11" 171
(length) (depth to top)
4" granular
(size) (material)
 - (6) pump 3/4 10
(HP) (yield gpm)
Black
(type power)
 - (7) electric log _____
(yes or no)
(organization running log)
 - (8) how well bottom plugged Cap

CODED

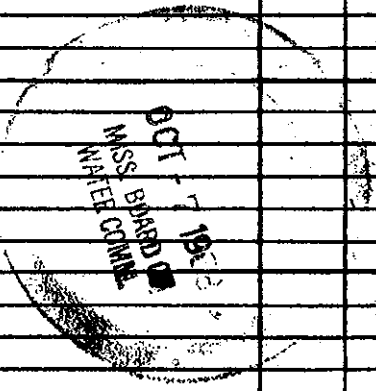

DRILLERS REMARKS: