


De Soto
K 112
10/31/74

MISSISSIPPI
BOARD OF WATER COMMISSIONERS
416 North State Street
Jackson, Mississippi 39201
CODED

WATER WELL DRILLERS LOG

10-31-74 date well completed
Hicks Sup. Well Co. firm name
De Soto county well located

LANDOWNER:	description of formations encountered	from	to
(mailing address)			
Paul Perkins Hermanns, Miss.	Red Clay	0	15
	Red Sand	15	45
WELL LOCATION: sec. 14 T. 3 N. R. 8 E 3 miles E of Hermanns	White Clay	45	60
	Black Clay	60	120
WELL PURPOSE: Home (home, irrigation, municipal, industrial)	Black Clay & white sand	120	135
WELL COMPLETION DATA: (1) diameter (inches) 4 1/2 in	White Clay & Sand	135	180
(2) total depth (feet) 260	Black Mounded	180	210
(3) static water level (feet) 150 below top of ground	White Sand	210	260
(4) casing (material) Plastic, (depth) 260			
(5) screen (length) 7 ft, (depth to top) 253			
(6) pump (HP) 1/2, (yield gpm) 10			
(7) electric log (yes or no) No			
(8) how well bottom plugged Cap			
DRILLERS REMARKS:			

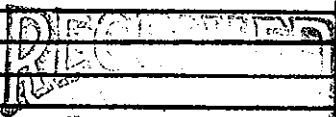

DEC - 2 1974