

De SOTO  
K 13  
10-18-74


MISSISSIPPI  
BOARD OF WATER COMMISSIONERS  
416 North State Street  
Jackson, Mississippi 39201

CODED

WATER WELL DRILLERS LOG

10-18 date well completed  
1974 Bel Smith Well Drilling firm name  
De Soto county well located

LANDOWNER: <u>Bill Manning</u> <u>Wheeler Rd.</u> <u>Derrando, Miss.</u> (mailing address)	description of formations encountered	from	to
WELL LOCATION: sec. <u>17</u> T. <u>4</u> N R. <u>2</u> E <u>5</u> miles <u>S</u> of <u>Hammond</u> (distance) (direction) (nearest town)			
WELL PURPOSE: <u>Home</u> (home, irrigation, municipal, industrial)	<u>white clay &amp; sand</u>	<u>20'</u>	<u>40'</u>
WELL COMPLETION DATA: (1) diameter (inches) <u>4"</u> (2) total depth (feet) <u>65'</u> (3) static water level (feet) <u>42'</u> below above top of ground. (4) casing <u>plastic</u> , <u>10'</u> (material) (depth) (size) if telescope see back. (5) screen <u>10'</u> <u>55'</u> (length) (depth to top) <u>4"</u> <u>plastic</u> (size) (material) (6) pump <u>1/2</u> <u>10</u> (HP) (yield gpm) <u>electric</u> (type power) (7) electric log <u>no</u> (yes or no) (organization running log) (8) how well bottom plugged <u>plugged</u>	<u>40'</u>	<u>65'</u>	

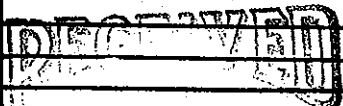

DEC 19 1974

DRILLERS REMARKS:

MISS. BD. OF WATER COMM