
County: Desoto Permit #: Driller: Jones w. Maser Date drilling completed: 1-14-05	Mississippi Department Office of Land a P.O. B Jackson, M (601)354	port and Well Log of Environmental Quality nd Water Resources fox 10631 S 39289-0631 961-5210 4-6938 (fax) driller in detail and filed wit	For Office Use Only: Aquifer:
State Law requires that this report be prepared by the or 30 days of completion of drilling of the well. Well Owner Information Owner Name Frank Stringfella Mailing Address: 2633 Conver Place Na		Well Location Latitude: 34.49, 36" Longitude: 00.02, 192 Method of Lat/Long (circle one): Conventional Survey, USGS quad, (Hand-held GPS) Survey-grade GPS	
hernodo City Telephone No. (901) 488-5		<u>SE <u>1</u> <u>S</u> <u>1</u> <u>Sec</u> <u>1</u> <u>Distance</u> <u>Direction</u> <u>Data</u></u>	Nearest Town of <u>hereodo</u>
~			re Other:
Purpose of Well (circle one) Home Date well drilling started:U If flowing, method of flow regulation Static Water Level:f Method of Measurement (circle one) Hole depth: We	- United type Discrete type	ate well drilling completed: er (describe) <u>NA</u> ne) land surface Date measu tape air line other:	ured: 1-14-05 string liveight
	Casing diameter: Screen diameter: to ches Setting depth: Fro able): Gravel packed U		en: poc 100 feet Open hole Natural Developme
Top of lap pipe or reduction in casin Logs run (circle all applicable): No	g: <u>NA</u> feet.	If telescoped or more than o	ne screen, describe on back of p
Name of organization running log(s) I certify that the well was drilled, construc Environmental Quality and/or the Mississi James W. Masa): ted, and completed in accordanc ippi Department of Health regula	e with all applicable requirements o ations and state laws.	f the Mississippi Department of
Print Name of Water Well Contract		Signatur	e of Water Well Contractor
Print Name of Water Well Contract	ow and show depths.		RECEIVED
n wen telestopes press and			FEB 1 5 2005 BY: OLWR

If well telescopes please sketch below and show depths.

1/ 100	Description of Formations Encountered	From	10
Ground Level K- 192	Clay dirt.	0	25
	white day	25	60
	grovel	60	70
and the second	white soud	20	80
		68	85
	white clay	85	90
	per grouel	90	100
 A state of the sta	while sad	10	1
			+
			+
			-
			+
and the second dependence of the second s			
and the state of t			1
			1

If more than one screen, show location of each on sketch

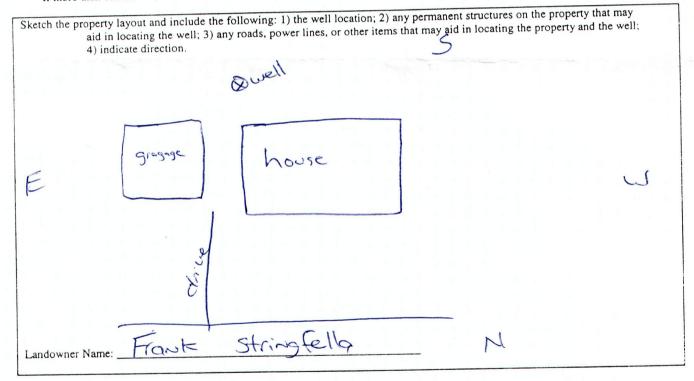

Signature of Water Well Contractor

RECEIVED FEB 1 5 2005 BY: OLWR

		LL REPORT						
County: Desoto		Completion Report	For Office Use Only:					
	r ump instanter s	Completion Report	Aquifer:					
Permit #: Driller: Jones w. Maser		of Environmental Quality	Well #: K-192					
		nd Water Resources ox 10631	Elevation:					
Date completed: 1-14-05		MS 39289-0631)961-5210						
This report must be prepar	ed by the pump installer in (601)354	-6938 (fax) detail and filed with the De	partment within 30 days of the					
installation of pump. A cop	y of Part 1 of this report mu	st be attached to this repor	t					
Well Owner Information Owner Name: <u>Frank String fells</u> Mailing Address: <u>3633 Lannar Place</u> N. <u>herwado ms 38637</u> City State Zip Code		Well Location Latitude: <u>34-49-933</u> Longitude: <u>090.02</u> , 122 Method of Lat/Long (circle one): Conventional Survey, USGS quad, Hand-held GPS, Survey-grade GPS						
					<u>SE 1/ Sw 1/ Sec 10 Twn 35 Rng 8w</u> Distance Direction Nearest Town			
							Telephone No. (901) 488-	5772
		Pump Ty	pe		wer Type			
		Circle on		C	Circle one			
Air Lift Jet	Submersible	Diesel Engine Gase	oline Engine Natural Ga					
Bucket Piston	Turbine	Electric Motor Har	nd Tractor PTC					
Centrifugal Rotary	Flowing Well		er (specify):					
		Horse Power Rating of Mo	tor: 314					
Other (specify):			80'					
Date Pump Installed: 1 - 14	F-04	Setting Depth:	50feet					
Rated Pump Capacity:	Gallons Per Minute	Number of Stages:						
Rated Pump Capacity:	Gallons I er Willide		.2.1					
D. Trat	Data	Method of M	easuring Water Level					
Pump Test			Circle one					
Date Well Tested:	- 04	Electric N	Aeasuring Line Steel Tape					
Static Water Level (A):	Fast Relow Land Surface							
		Other (specify):	ng lweight					
Pumping Water Level (B): <u>NA</u>	Feet Below Land Surface							
Drawdown [(B) – (A)]: <u>NA</u>	Feet Below Land Surface	For flowing well, measured	d shut in head:fee					
Test Pumping Rate: 12		Well yielded l 🕻	GPM with a drawdown of					
Duration of Pump Test (minimum 4	haven 24 hours	A) A feet afte	rhours of pumpin					
Duration of Pump Test (minimum 4	hours): <u>v</u> hours							
I HEREBY CERTIFY that the above	ve statements are true to the be	est of my knowledge.						
55		0						
Jones W. Mason	·	Signature of Pump Inc	staller					
Print Name of Pump Installer and L	icense No. (if applicable)	Signature of Fump Inc	RECEIVED					
			FEB 1 5 2005					
			BY: OLWR					

\$\$\$ C. 200