
			·
County: Desoto	Well Driller Re	port and Well Log	For Office Use Only:
Permit #:	Mississippi Department of Environmental Quality		Well #: K-193
Driller: Jones W. Mason	Office of Land and Water Resources P.O. Box 10631		L. S. Elevation:
Date drilling completed: $\underline{9-4-05}$	Jackson, N	IS 39289-0631	E-log #:
		961-5210 4-6938 (fax)	L-10g #.
State Law requires that this re	port be prepared by the	driller in detail and filed with	h the Department within
30 days of completion of drilli	ng of the well.	1	LL contion
Well Owner Inform		74 49.94	K
Owner Name Kaiden Homes IIc		Latitude: 34.49,947, Longitude: 00.00,372,	
Mailing Address: Lot 25		Method of Lat/Long (circle one): Conventional Survey,	
La Grave		USGS quad Hand-held GPS, Survey-grade GPS	
herrodo ns <u>38637</u> City State Zip Code		SE 1/ SW 1/4 Sec_ 1	VTwn 35 Rng Bw
City State Zip Code		Distance Direction	Nearest Town
Telephone No. (901) 494 - 49	541	$\underline{3}$ Miles $\underline{\omega}$	of hermodo
		l Data	
Purpose of Well (circle one Home)	Industrial Public Supp	ly Irrigation Fish Cultur	e Other:
Purpose of wen (circle one) Tione		ate well drilling completed:	
Date well drilling started:			
If flowing, method of flow regulation:	Valve <u>Dra</u> Oth	er (describe)	2-4-05
Static Water Level:fe	et above or below (circle c	ne) land surface Date measu	ared: 0 1 05
Method of Measurement (circle one)	steel tape electric	tape air line other:	String / weight
Hole depth: <u>80</u> Wel	1 depth: <u>80</u>	Well grouted to a depth	of <u>(O</u> feet
Type of grout (circle one): Cement		Mix	
Casing length: <u>70</u> feet	Casing diameter:	inches Type of casi	$ng: -\rho \cup C$
Screen length: (O feet	Screen diameter:	<u>-(</u> inches Type of scre	en: <u><u>puc</u></u>
Screen slot size: 0 (0 incl	nes Setting depth: Fr	om 70feet to_	80feet
Screen slot size.		Jnderreamed Telescoped	Open hole Natural Development
Type of completion (circle all applica			
	Other (describe): _		
Top of lap pipe or reduction in casing	$: \underline{NA}$ feet.	If telescoped or more than o	ne screen, describe on back of page
Logs run (circle all applicable). No l	og run Electric Gamma	a Ray Density Sonic Neut	ron Other:
Name of organization running log(s): I certify that the well was drilled, construct	d and completed in accordance	e with all applicable requirements o	f the Mississippi Department of
I certify that the well was drilled, constructed Environmental Quality and/or the Mississip	ppi Department of Health regul	ations and state laws.	
			2
Jones W. Mason		- Jose .	e of Water Well Contractor
Print Name of Water Well Contracto		Signature	
If well telescopes please sketch belo	w and show depths.		RECEIVED
			FEB 2 8 2015
			BY: OLWR

• 4

۰.4

If well telescopes please sketch below and show depths.

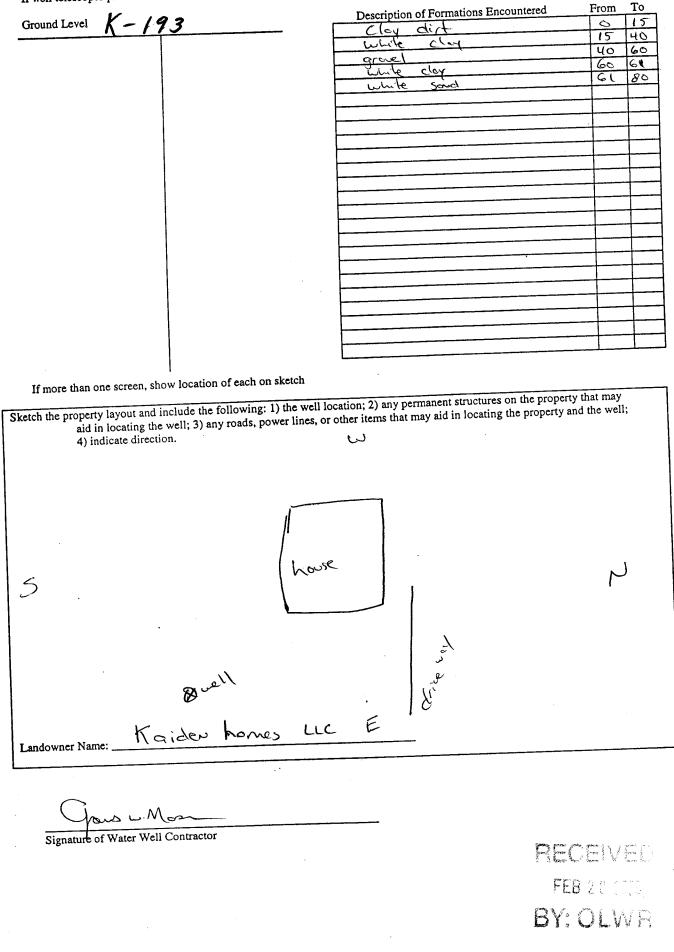

EPORT on Report nmental Quality tesources 631 For Office Use Only: Aquifer: 4quifer:	
For Office Use Only: Aquifer: 631 K-193	
Elevation:	
with the Department within 30 days of the	
Well Location	
Latitude: 34,49,947 Longitude: 090.03,272	
Method of Lat/Long (circle one): Conventional Survey,	
USGS quad, Hand-held GPS, Survey-grade GPS	
<u>SE 14 SW 14 Sec 10 Twn 35 Rng 8 W</u> Distance Direction Nearest Town	
_Miles ofdo	
Power Type Circle one	
Engine Gasoline Engine Natural Gas	
Motor Hand	
Other (specify):	
Depth:feet	
r of Stages: ll	
Method of Measuring Water Level Circle one	
e Electric Measuring Line Steel Tape	
(specify): _String (weight	
wing well, measured shut in head: $\underline{\mathcal{N}}^{\underline{\mathcal{A}}}$ feet	
Well yielded GPM with a drawdown of	
A feet after <u>24</u> hours of pumping	
nuledge	
JAI09201	
Signature of Pump Installer	

4

FEB 2 8 STA