
County: Desoto	Well Driller Rep	ort and Well Log	For Office Use Only:
Permit #:	Office of Land an P.O. Bo Jackson, MS (601)9 (601)354	of Environmental Quality d Water Resources ox 10631 5 39289-0631 61-5210 -6938 (fax)	Well #: <u>K-213</u> L. S. Elevation: E-log #:
State Law requires that this 30 days of completion of dril	report be prepared by the c ling of the well.		
Well Owner Infor	mation		Il Location
Owner Name H-M Construction.		Latitude: 34 . 49 . 94	2 " Longitude: 90 · 02 · 839 " 50
Mailing Address: LOT 16		Method of Lat/Long (circle of	
Sunset Id.		USGS quad Hand-held GPS, Survey-grade GPS	
Hernodo City Telephone No. (901) 238-	MS 38632 State Zip Code		Twn <u>35</u> Rng 865 Nearest Town of <u>free corner</u>
	Well		· · · · · · · · · · · · · · · · · · ·
Purpose of Well (circle one Home Date well drilling started:	5-05 Da	te well drilling completed:	6-5-05
If flowing, method of flow regulation	: Valve <u>JA</u> Othe	r (describe)	20.91.5
Static Water Level:	eet above or below (circle on	e) land surface Date meas	ured: 6-(
Mathad of Measurement (circle one)	steel tape electric ta	ape air line other:	String loverger
Hole depth: 80 w	ell depth:O	Well grouted to a depth	n offeet
Type of grout (circle one): Cemer		ſix	
		inches Type of cas	ing: poc
Screen length: <u>10</u> feet	Screen diameter: 4	inches Type of scre	een: <u>puc</u>
Screen length:lect	ches Setting depth: Fro	m feet to	70 feet
Type of completion (circle all applic	able): Gravel packed U	nderreamed Telescoped	Open hole Natural Developmen
I ype of completion (circle an applied	Other (describe):		
Top of lap pipe or reduction in casir		If talescoped or more than o	ne screen, describe on back of pag
Top of lap pipe or reduction in casir	ig: <u>P7</u> teet.	n telescoped of more than o	tron Other:
Logs run (circle all applicable). No			
Name of organization running log(s I certify that the well was drilled, construct): ted, and completed in accordance	with all applicable requirements o	f the Mississippi Department of
I certify that the well was drilled, construct Environmental Quality and/or the Mississ	ippi Department of Health regular	tions and state laws.	
		Gene	v. Mon
Jores w. Moson		Signatur	e of Water Well Contractor
Print Name of Water Well Contract If well telescopes please sketch be	low and show depths.		RECEIVE
			JUN 2 9 2005
			BY: OLWI

K-213

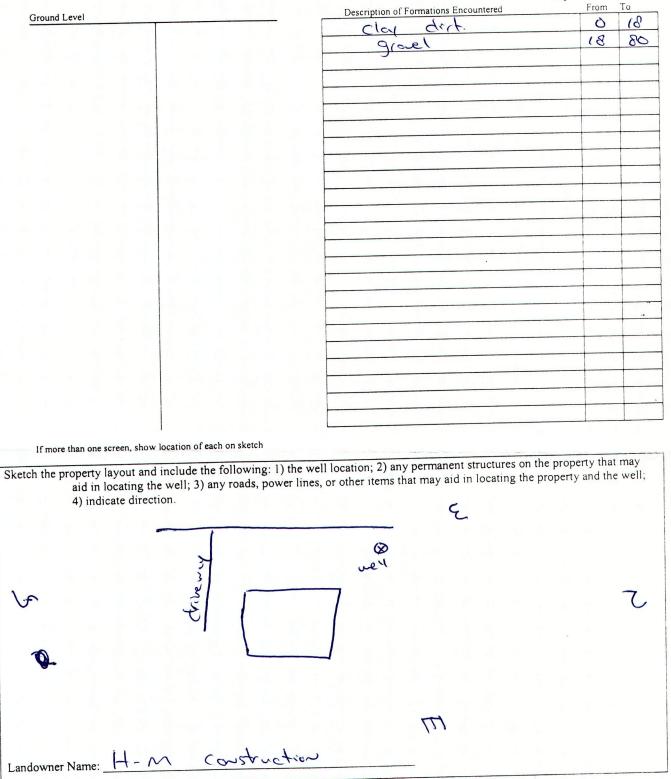

Signature of Water Well Contractor

RECEIVED JUN 2 9 2005 **BY: OLWR**

STATE WEI Par	rt 2	For Office Use Only:	
County: Desoto Pump Installer's C			
ermit #: Mississippi Department of Oriller: Jores w. Mosw Date completed: 6-19-05 Jackson, MS (601)96	Water Resources x 10631 39289-0631 51-5210	Aquifer:	
(601)354- This report must be prepared by the pump installer in d	etail and filed with the De	epartment within 30 days of the	
This report must be prepared by the pump instance in u installation of pump. A copy of Part 1 of this report mus	t be attached to this repo	rt. ell Location	
Well Owner Information			
Dwner Name: (1) of COUSTING	Latitude: 34.49.942 Longitude: 0.02.839		
Mailing Address: LOT (6	Method of Lat/Long (circle one): Conventional Survey,		
Sunset id	USGS quad, Hand-held GPS, Survey-grade GPS SE 1/2 5 6 1/2 Sec 9 Twn 35 Rng 8 6		
<u> </u>			
Herrodo ms 38632 City State Zip Code			
	Distance	of free corner	
Telephone No. (901) 238 - 7838	Miles	of thee conne	
		Power Type	
Pump Type	1.11	Circle one	
Circle one Submersible	Diesel Engine Ga	asoline Engine Natural Gas	
Air Lift Jet Submersible		Tractor PTO	
Bucket Piston Turbine	Electric Word	Other (specify):	
Centrifugal Rotary Flowing Well			
Other (specify):	Horse Power Rating of M	Motor: 314	
Date Pump Installed:	Setting Depth:	50 feet	
Date Pump Installed:	Number of Stages:		
Rated Pump Capacity: (\rightarrow Gallons Per Minute			
	Method o	f Measuring Water Level	
Pump Test Data		Circle one	
Date Well Tested: 6-19-05	Air Line Electr	ic Measuring Line Steel Tape	
Static Water Level (A):Feet Below Land Surface		ing (meight	
Pumping Water Level (B): NA Feet Below Land Surface			
Pumping Water Level (B): rect Determined Surface	For flowing well, meas	sured shut in head: fee	
Drawdown [(B) – (A)]:Feet Below Land Surface		GPM with a drawdown of	
Test Pumping Rate: Gallons Per Minute		after 24 hours of pumping	
Duration of Pump Test (minimum 4 hours): <u>24</u> hours	feet	after nouis er part p	
I HEREBY CERTIFY that the above statements are true to the	best of my knowledge.	~~~~~	
	Signature of Pum	p Installer	
Print Name of Pump Installer and License No. (if applicable)	O'Brittin 2	RECEIVE	
		JUN 2 9 200	
		BY: OLW	