0	State Well Report Part 1 – Driller's Log	For Office Use Only:
County: Desats	Mississippi Department of Environmental Quality	Aquifer:
Permit #:	Office of Land and Water Resources	11 0.00
Driller: Jones w. Moson.	P.O. Box 10631	Well #: <u>R-249</u>
	Jackson, MS 39289-0631	L. S. Elevation:
Date drilling completed: 10-18-06	(601)961-5210	
	(601)354-6938 (fax)	E-log #:

State Law requires that this report be prepared by the license holder responsible for the work and filed with the Department at the above address within 30 days of completion of drilling of the well or borehole.

Information on Well Owner	Well or Borehole Location			
(Landowner if borehole is not for a water well)	24 40 226			
Owner Name Mike Borton	Latitude: $\frac{34}{23} \cdot \frac{49}{23}$ · Longitude: $\frac{690}{23} \cdot \frac{03}{23}$			
Mailing Address: 2524 Horn Lake Rd.	Method of Lat/Long (circle one): Conventional Survey,			
Bor E ronchettes	USGS quad, Hand-held GPS, Survey-grade GPS <u>SE</u> 1/4 Sec_17 Twn_35 Rng 865			
Iterrando mo 352037 City State Zip Code	NE SE			
	Distance Direction Nearest Town <u>3/4</u> Miles <u>5</u> of <u>frees</u> conver			
Telephone No. (901) 412-9579				
Well / Bore	hole Data			
Date drilling started: $(0 - (3 - 0))$ Date drilling completed: $(0 - (3 - 0))$	Hole depth: $140'$ Hole diameter: $63/4''$			
Location of the source of any surface water used for drilling:	4			
Method of dosing and volume of Chlorine used in drilling and deve	lopment: <u>NA</u>			
Logs run (circle all applicable): No log run Electric Gamma Ray Density Sonic Neutron Other:				
Purpose of borehole (check one): Water Well Ceotechnical/Geol	ogical Investigation Ground Source Heat Pump			
Seismic SurveyOther (<i>describe</i>) If drilling is not related to water well construction, skip the remainder of this block				
Purpose of Well (check one): Home 🗹 Industrial Public Supply Irrigation Fish Culture Other:				
If a flowing well, method of flow regulation: Valve <u>~ A</u> C	Other (describe)			
Static Water Level: 5 5 ' feet above or below (circle one)	land surface Date measured: 10-18-06			
Method of Measurement (circle one) steel tape electric tape	air line other: string [weight			
Well depth: <u>140</u> Well grouted to a depth of <u>()</u> feet Type of grout (circle one): Neat Cement Bentonite Mix				
Casing length: 120 feet Casing diameter: 4 inches Type of casing: prot				
Screen length: $\underline{\partial \circ}$ feet Screen diameter: $\underline{\prime}$ inches Type of screen: $\underline{\rho \circ c}$				
Screen slot size: (010) inches Setting depth: From 120 feet to 140 feet				
Type of completion (circle all applicable) Gravel packed Unde	rreamed Telescoped Open hole Natural Development			
Other (describe):	ALA			
Top of lap pipe or reduction in casing: $\sim A$ feet. If the	elescoped or more than one screen, describe on next page			

NOV 17 2006 BY: OLWR

249


Description of formations encountered must be provided for all wells and boreholes, unless specifically exempted by regulations

The sketch below only required for water wells

If well telescopes,	show	depths	on	sketch.
Ground Level.		7		

d Level	Description of Formations Encountered		From (depth) To (depth)	
	Clear dict-	Ground Level	30	
	white day	30	55	
	white scoul	55	75	
	white day	75	100	
	bunity south	185	155	
			1	
			-	

If more than one screen, show location of each on sketch

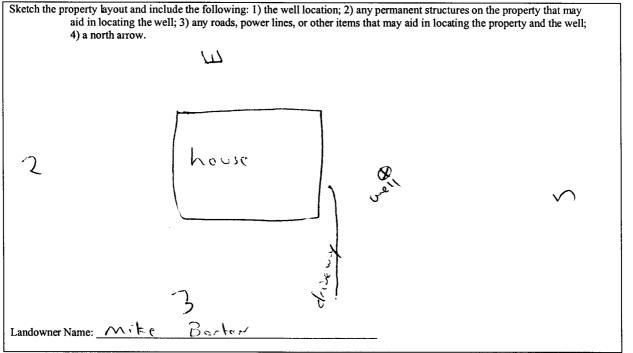

Form: OLWR-SWR-1A

I certify that the well/borehole was drilled, constructed, and completed in accordance with all applicable requirements of the Mississippi Department of Environmental Quality and the Mississippi Department of Health regulations, if applicable, and state laws.

Date

Jones W. Mason 0-620 11-13-06

Print Name of Responsible Licensee and License No.

Signature of Licensee PECEIVED

NOV 17 2006 BY: OLWR

	STATE WELL REPORT	
County: Desoto	Part 2 Pump Installer's Completion Report	For Office Use Only:
Permit #:	Mississippi Department of Environmental Quality	Aquifer:
Driller: Jones w. Mason	Office of Land and Water Resources P.O. Box 10631	1) 2//0
Date completed: 10-19-06	Jackson, MS 39289-0631 (601)961-5210	Well #: $R - 297$
Copy information from block on Part 1	(601)354-6938 (fax)	Elevation:

This part of the report must be completed by a licensed water well contractor or a licensed pump installer. A copy of Part 1 of the
report must be attached and both parts filed with the Department at the above address within 30 days of well completion.Well Owner InformationWell Location

Owner Name: <u>/</u>			. 00
Mailing Address	2524	Hornla	le Kel.
	Bor E	Tonche	Her-
	Hernodo	MG	38637
	City	State	Zip Code
Telephone No. (901) 41	2- 9579	

Well Location
Latitude: 34.49-379 Longitude: 090:030-722
Method of Lat/Long (check one): Conventional Survey,
USGS quad, Hand-held GP9, Survey-grade GPS
<u>SE 4 NE 4 Sec 17 T 35 R 800</u>
Distance Direction Nearest Town
314 Miles SE of frees conver

Pump Type Circle one			Power Type Circle one		
Air Lift	Jet	Submersible	Diesel Engine	Gasoline Engine	Natural Gas
Bucket	Piston	Turbine	Electric Motor	Hand	Tractor PTO
Centrifugal	Rotary	Flowing Well	Windmill	Other (specify):	<u>- dh- 16</u>
Other (specify):			Horse Power Ratin	g of Motor:l_2	
Date Pump Installed	: 10 - 18-	06	Setting Depth:	08	feet
Rated Pump Capacit	y:O	Gallons Per Minute	Number of Stages:	14	

Pump Test Data	Method of Measuring Water Level Circle one		
Date Well Tested: 10-18-06			
Static Water Level (A): 55 Feet Below Land Surface	Air Line Electric Measuring Line Steel Tape		
Pumping Water Level (B): NA Feet Below Land Surface	Other (specify): String weight		
	A A A A A A A A A A A A A A A A A A A		
Drawdown [(B) – (A)]:Feet Below Land Surface	For flowing well, measured shut in head:feet		
Test Pumping Rate:Gallons Per Minute	Well yieldedGPM with a drawdown of		
Duration of Pump Test (minimum 4 hours):hours	feet afterhours of pumping		

I HEREBY CERTIFY that the above statements are true to the best o	f my knowledge.	
Print Name of Pump Installer and License No. (if applicable)	Signature of Pump Installer	RECEIVED
		Form: OLWR-SWR-1B
		BY: OLWR