

STATE WELL REPORT

Part 1

Driller's Log

Mississippi Department of Environmental Quality
Office of Land and Water Resources
P.O. Box 2309
Jackson, MS 39225-2309
(601)961-5210
(601)360-0535 (fax)

County: DESO
Permit #: _____
Driller: BOB SMITH
Date drilling completed: 2-29-17

For Office Use Only:

Well #: K323
Aquifer: _____
E-Log #: _____

State Law requires that this report be prepared by the license holder responsible for the work and filed with the Department at the above address within 30 days of completion of drilling of the well or borehole.

Well Owner Information <small>(Landowner if borehole is not for a water well)</small>	Well or Borehole Location
Owner Name: <u>VICTOR OROAZ</u>	Latitude: <u>34°44'29.76"</u> Longitude: <u>90° 0'47.64"</u>
Mailing Address: <u>1407 WHEELER RD</u>	Method of Lat/Long (check one): Conventional Survey _____
<u>HEMLOCK, MS 38632</u>	USGS quad _____, Hand-held GPS _____, Survey-grade GPS _____
City: _____ State: _____ Zip Code: _____	<u>NW ¼ NE ¼, Sec 1A T 45 R 8W</u>
Telephone No. <u>(901) 288-0922</u>	Miles _____ of _____ (Distance) (Direction) (Nearest Town)

Well / Borehole Data

Date drilling started: 2-29-17 Date drilling completed: 2-29-17 Hole depth: 167 Hole diameter: 8"

Location of the source of any surface water used for drilling: _____

Method of dosing and volume of Chlorine used in drilling and development: 5 ppm

Logs run (circle all applicable): No log run Electric Gamma Ray Density Sonic Neutron Other: _____

Name of organization running log(s): _____

Purpose of borehole (circle one): **Water Well** Geotechnical/Geological Investigation Ground Source Heat Pump
 Seismic Survey Other (describe) _____

If drilling is not related to water well construction, skip the remainder of this block

Purpose of Well (circle all applicable): **Home** Industrial Public Supply Irrigation Fish Culture

Other (describe): _____

If a flowing well, method of flow regulation: Valve _____ Other (describe) _____

Static Water Level: 104 feet (above or below) land surface Date measured: 2-29-17
(circle one)

Method of measurement (circle one): Steel tape Electric tape Air line Other (describe): LINE + WEIGHT

Well depth: 167 Well grouted to a depth of: 10 feet Type of grout (circle one): Neat Cement **Bentonite** Mix

Casing length: 157 feet Casing diameter: 4 inches Type of casing: PVC

Screen length: 10 feet Screen diameter: 4 inches Type of screen: PVC

Screen slot size: 13 THOUS. inches Setting depth: From 157 feet to 167 feet

Type of completion (circle all applicable): Gravel packed Underreamed Open hole Natural Development

Other (describe): _____

Top of lap pipe or reduction in casing: _____ feet

If telescoped or more than one screen, describe on next page

RECEIVED
MAR 24 2017

STATE WELL REPORT

Part 2

Pump Installer's Completion Report
 Mississippi Department of Environmental Quality
 Office of Land and Water Resources
 P.O. Box 2309
 Jackson, MS 39225-2309
 (601)964-5210
 (601) 360-8535 (fax)

County: DECATO
 Permit #: _____
 Driller: Bob Smith
 Date completed: 2-29-17
Copy information from block on Part 1

For Office Use Only:

Well #: K323
 Aquifer: _____

This part of the report must be completed by a licensed water well contractor or a licensed pump installer. A copy of Part 1 of the report must be attached and both parts filed with the Department at the above address within 30 days of well completion.

Well Owner Information	Well Location
Owner Name: <u>VICTOR ONDAZ</u>	Latitude: <u>39°44'29.76"</u> Longitude: <u>90°0'47.64"</u>
Mailing Address: <u>1407 Wheeler Rd</u>	Method of Lat/Long (check one): Conventional Survey _____
<u>HERNANDO</u> MS <u>38632</u>	USGS quad _____ Hand-held GPS _____ Survey-grade GPS _____
(City) State Zip Code	<u>NW 1/4 NE 1/4, Sec 14 T 4S R 8W</u>
Telephone No. <u>901 288-0922</u>	Miles _____ of _____ (Distance) (Direction) (Nearest Town)

Pump Type (circle one)

Submersible Turbine Air Lift Centrifugal Flowing Well Jet Piston Rotary Other (describe): _____

Date Pump Installed: 2-29-17 Rated Pump Capacity: 20 Gallons Per Minute

Is This Pump (circle one): New Repaired Replacement

Power Type (circle one)

Electric Diesel Gasoline Natural Gas Tractor PTO Windmill Other (describe): _____

Horse Power Rating of Motor: 1 1/2 Setting Depth: 120 feet Number of Stages: 12

Pump Test Data for Non Flowing Well

Date Well Tested: 2-29-17 Duration of Pump Test (minimum 4 hours): _____ hours

Static Water Level (A): 104 Feet Below Land Surface Pumping Water Level (B): _____ Feet Below Land Surface

Drawdown (B) - (A): _____ Feet Below Land Surface Test Pumping Rate: 25 Gallons Per Minute

Method of measurement (circle one): Steel tape Electric tape Air line Other (describe): LINE + WEIGHT

Pump Test Data for Flowing Well

Measured shut in head: _____ feet

Well yielded _____ GPM with a drawdown of _____ feet after _____ hours of pumping

Meter Installation

Meter Manufacturer: _____ Meter Serial Number: RECEIVED

Meter Model Number/Name: _____ Type of Meter: _____

Totalizer Register Unit and Multiplier Factor (AF x .001, gal x 1000, etc): MAR 24 2017

Installation Date: _____ Meter installed by: BY OLWR

Is This Meter (circle one): New Repaired Replacement

Important: By submitting the above information you are certifying that this meter was installed to manufacturer standards. For agricultural wells, a list of approved meters is on the MDEQ website.

I HEREBY CERTIFY that the above statements are true to the best of my knowledge.


Bob Smith 0645 3/27/17 [Signature]
 Print Name of Pump Installer and License No. (if applicable) Date Signature of Pump Installer

County: _____
 Permit #: _____

For Office Use Only:
 Well #: K323

The sketch below only required for water wells

If well telescopes, show depths on sketch

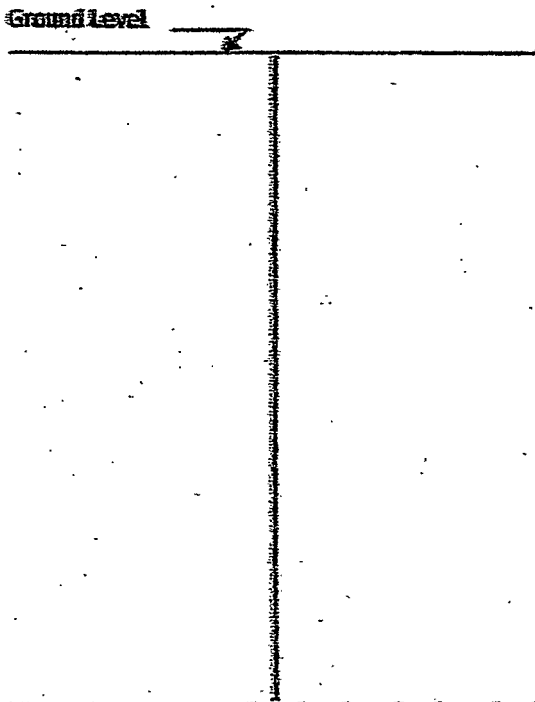


Description of formations encountered must be provided for all wells and boreholes unless specifically exempted by regulations

Description of Formations Encountered	From (depth)	To (depth)
TOP SOIL	0	10
TOP SOIL BROWN CLAY	10	18
RED CLAY	18	30
OR PVEL	30	42
WHITE CLAY	42	110
WHITE SAND CLAY	110	130
WHITE SAND	130	167

If more than one screen, show location of each on sketch

Sketch the property layout and include the following:

- 1) the well location
- 2) any permanent structures on the property that may aid in locating the well
- 3) any roads, power lines, or other items that may aid in locating the property and the well
- 4) north arrow

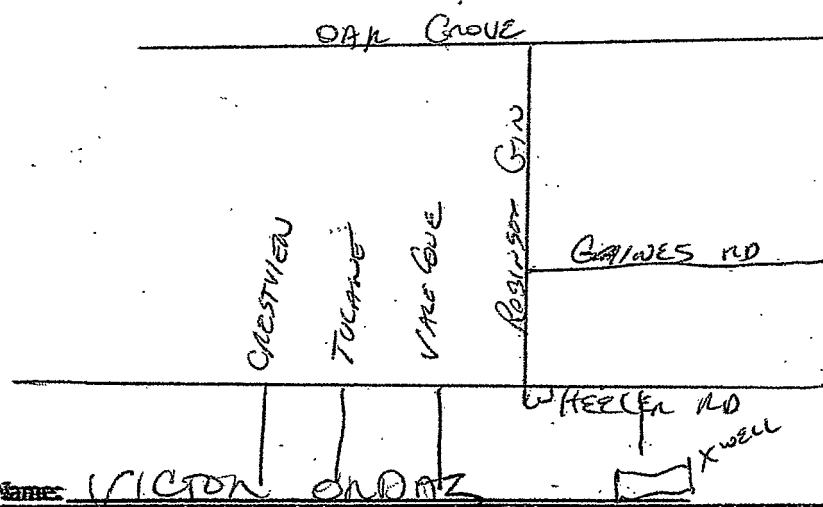

1704 ST
 PERMIT
 SUCUM
 1002 RD
 RECEIVED
 MAR 24 2017
 BY OLWR

Landowner Name: VICTOR ONDRAZ

I HEREBY CERTIFY that the well/borehole was drilled, constructed, and completed in accordance with all applicable requirements of the Mississippi Department of Environmental Quality and the Mississippi Department of Health regulations, if applicable, and state laws.

BOB SMITH 0645 3-22-17
 Print Name of Responsible Licensee and License No. Date

[Signature]
 Signature of Licensee