

# STATE WELL REPORT

County: DESOUD  
 Permit #: \_\_\_\_\_  
 Driller: Bob Smith  
 Date drilling completed: 12-3-17

Part I  
 Driller's Log  
 Mississippi Department of Environmental Quality  
 Office of Land and Water Resources  
 P.O. Box 2309  
 Jackson, MS 39225-2309  
 (601)961-5210  
 (601)368-0535 (fax)

**For Office Use Only:**

Well #: K 327  
 Aquifer: \_\_\_\_\_  
 E-Log #: \_\_\_\_\_

*State Law requires that this report be prepared by the license holder responsible for the work and filed with the Department at the above address within 30 days of completion of drilling of the well or borehole.*

Well Owner Information <small>(Landowner if borehole is not for a water well)</small>	Well or Borehole Location
Owner Name: <u>Pentac Construction</u>	Latitude: <u>34° 25' 51.5"</u> Longitude: <u>90° 01' 26.11"</u>
Mailing Address: <u>1757 ROYAL LANE</u>	Method of Lat/Long (check one): Conventional Survey _____
City: <u>HEWLETT</u> State: <u>MS</u> Zip Code: <u>38632</u>	USGS quad _____, Hand-held GPS _____, Survey-grade GPS _____
Telephone No.: <u>(601) 278-6255</u>	<u>SE 1/4 NW 1/4, Sec 14 T 3S R 8W</u>
	Miles _____ of _____ (Distance) (Direction) (Nearest Town)

**Well / Borehole Data**

Date drilling started: 12-3-17 Date drilling completed: 12-3-17 Hole depth: 215 Hole diameter: 4

Location of the source of any surface water used for drilling: \_\_\_\_\_

Method of dosing and volume of Chlorine used in drilling and development: 5 PPM

Logs run (circle all applicable): No log run  Electric  Gamma Ray  Density  Sonic  Neutron  Other: \_\_\_\_\_

Name of organization running log(s): \_\_\_\_\_

Purpose of borehole (circle one):  Water Well  Geotechnical/Geological Investigation  Ground Source Heat Pump  
 Seismic Survey  Other (describe) \_\_\_\_\_

RECEIVED

JAN 04 2018

BY OLWR

*If drilling is not related to water well construction, skip the remainder of this block.*

Purpose of Well (circle all applicable):  Home  Industrial  Public Supply  Irrigation  Fish Culture

Other (describe): \_\_\_\_\_

If a flowing well, method of flow regulation: Valve \_\_\_\_\_ Other (describe) \_\_\_\_\_

Static Water Level: 60 feet (above or  below land surface (circle one) Date measured: 12-3-17

Method of measurement (circle one): Steel tape   Electric tape  Air line  Other (describe) \_\_\_\_\_

Well depth: 215 Well grouted to a depth of: 10 feet Type of grout (circle one): Neat Cement   Bentonite  Mix

Casing length: 195 feet Casing diameter: 4 inches Type of casing: PVC

Screen length: 20 feet Screen diameter: 4 inches Type of screen: PVC

Screen slot size: 13 TENS inches Setting depth: From 195 feet to 215 feet

Type of completion (circle all applicable):  Gravel packed  Underreamed  Open hole  Natural Development

Other (describe): \_\_\_\_\_

Top of lap pipe or reduction in casing: \_\_\_\_\_ feet

*If telescoped or more than one screen, describe on next page*

# STATE WELL REPORT

Part 2

County: DE SOTO  
 Permit #: \_\_\_\_\_  
 Driller: BOB SMITH  
 Date completed: 12-3-17  
Copy information from Block in Part 1

**Pump Installer's Completion Report**  
 Mississippi Department of Environmental Quality  
 Office of Land and Water Resources  
 P.O. Box 2309  
 Jackson, MS 39275-2309  
 (601) 951-5210  
 (601) 350-9555 (fax)

**For Office Use Only:**  
 Well #: K327  
 Aquifer: \_\_\_\_\_

*This part of the report must be completed by a licensed water well contractor or a licensed pump installer. A copy of Part 1 of the report must be attached and both parts filed with the Department at the above address within 30 days of well completion.*

Well Owner Information	Well Location
Owner Name: <u>Pentam Construction</u>	Latitude: <u>34° 22' 51.51"</u> Longitude: <u>90° 01' 86.11"</u>
Mailing Address: <u>1752 ROYAL LAUREL</u>	Method of Lat/Long (check one): <u>Conventional Survey</u>
City: <u>HOVINGWOOD</u> State: <u>MS</u> Zip Code: <u>38632</u>	USGS quad _____ Hand-held GPS _____ Survey-grade GPS _____
Telephone No. (601) <u>278-6255</u>	<u>SE 1/4 NW 1/4, Sec. 14 T 35 R 8W</u>
	Miles _____ of _____ (Distance) (Direction) (Nearest Town)

**Pump Type (circle one)**

Submersible  Turbine  Air Lift  Centrifugal  Flowing Well  Jet  Piston  Rotary  Other (describe): \_\_\_\_\_

Date Pump Installed: 2-3-17 Rated Pump Capacity: 22 Gallons Per Minute

Is This Pump (circle one):  New  Repaired  Replacement

**Power Type (circle one)**

Electric  Diesel  Gasoline  Natural Gas  Tractor PTO  Windmill  Other (describe): \_\_\_\_\_

Horse Power Rating of Motor: 1 1/2 Setting Depth: 100 feet Number of Stages: 11

**Pump Test Data for Non-Flowing Well**

Date Well Tested: \_\_\_\_\_ Duration of Pump Test (minimum 4 hours): \_\_\_\_\_ hours

Static Water Level (A): 60 Feet Below Land Surface Pumping Water Level (B): \_\_\_\_\_ Feet Below Land Surface

Drawdown (B) - (A): \_\_\_\_\_ Feet Below Land Surface Test Pumping Rate: \_\_\_\_\_ Gallons Per Minute

Method of measurement (circle one):  Steel tape  Electric tape  Airline  Other (describe): \_\_\_\_\_

**Pump Test Data for Flowing Well**

Measured shut in head: \_\_\_\_\_ feet

Well yielded \_\_\_\_\_ GPM with a drawdown of \_\_\_\_\_ feet after \_\_\_\_\_ hours of pumping

**Meter Installation**

Meter Manufacturer: \_\_\_\_\_ Meter Serial Number: \_\_\_\_\_

Meter Model Number/Name: \_\_\_\_\_ Type of Meter: \_\_\_\_\_

Totalizer Register Unit and Multiplier Factor (AF x .001, gal x 1000, etc): \_\_\_\_\_

Installation Date: \_\_\_\_\_ Meter installed by: \_\_\_\_\_

Is This Meter (circle one):  New  Repaired  Replacement

RECEIVED  
JAN 04 2018  
BY OLWR

Important: By submitting the above information you are certifying that this meter was installed to manufacturer standards. For unconfined wells, a list of approved meters is on the OLWR website.

I HEREBY CERTIFY that the above statements are true to the best of my knowledge.

BOB SMITH 0645 12-30-17 \_\_\_\_\_  
 Print Name of Pump Installer and License No. (if applicable) Date Signature of Pump Installer

Form: OLWR-SWR-2A (4/17)


[The page contains extremely faint and illegible text, likely bleed-through from the reverse side of the document. The text is scattered across the page and does not form any recognizable words or sentences.]

County: DESOUD  
 Permit #: \_\_\_\_\_

**For Office Use Only:**  
 Well #: K327

The sketch below only required for water wells

If well telescopes, show depths on sketch

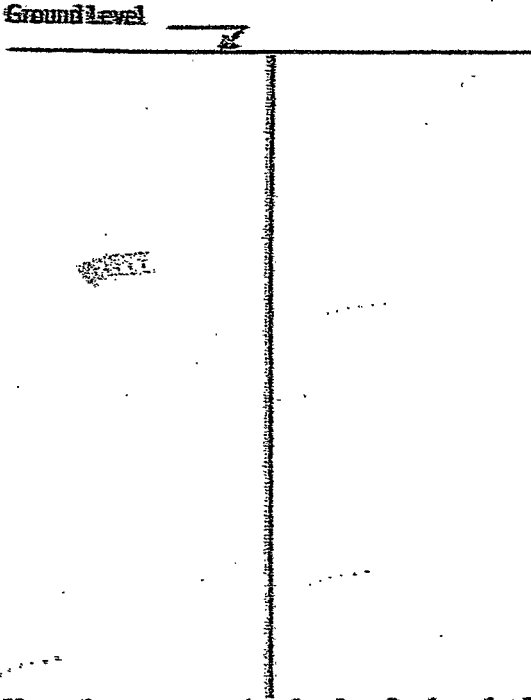


Description of formations encountered must be provided for all wells and boreholes, unless specifically exempted by regulations

Description of Formations Encountered	From (depth)	To (depth)
TOP SOIL	0	5
Brown CLAY	5	12
GRAVEL + SOIL	12	30
GREY CLAY	30	180
Rock	180	181
WHITE SAND	181	215

If more than one screen, show location of each on sketch

Sketch the property layout and include the following:

- 1) the well location
- 2) any permanent structures on the property that may aid in locating the well
- 3) any roads, power lines, or other items that may aid in locating the property and the well
- 4) north arrow

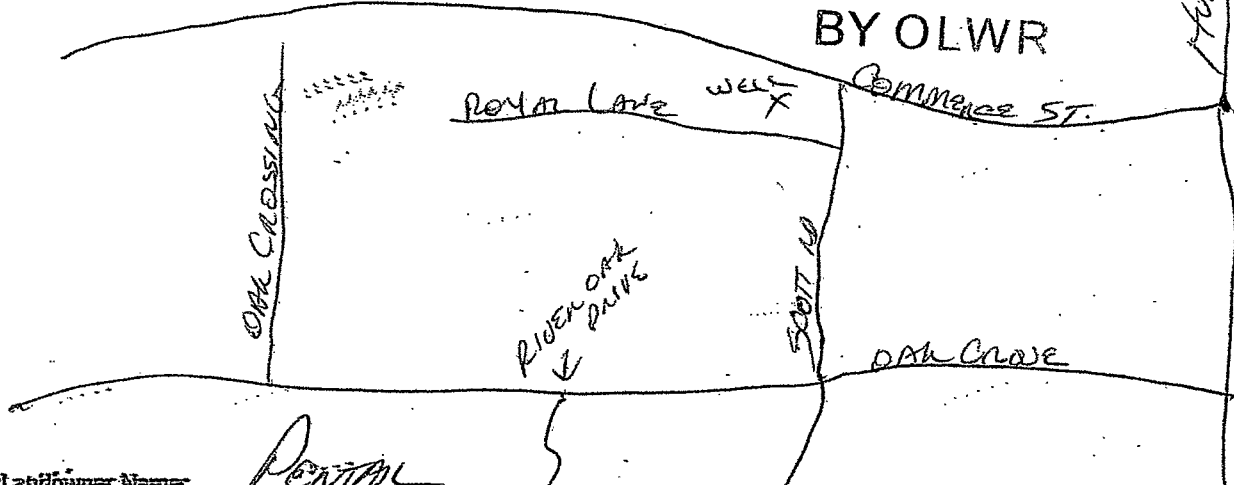

Landowner Name: PERNIA

I HEREBY CERTIFY that the well/borehole was drilled, constructed, and completed in accordance with all applicable requirements of the Mississippi Department of Environmental Quality and the Mississippi Department of Health's regulations, if applicable, and state laws.

ROB SMITH 0645 12-30-17 [Signature]  
 Print Name of Responsible Licensee and License No. Date Signature of Licensee