

Desoto

**K 201 WATER WELL DRILLERS LOG K**

7-29-60

Date: 7-29, 1960, Driller: H.C. Henderson County: Desoto

(Name)

(1) Owner of Land: <u>Yus Karris</u> (Name)	Description & Color of Materials Sand, Clay, Red Clay, Shell, etc.	Thick- ness Feet	Depth Feet
<u>Route 38</u> (Address)			
(2) Location: <u>1/4, 1/4, Sec 38</u> (distance) (direction) (Nearest Town)	<u>Red Clay</u>	<u>15'</u>	<u>64'</u>
(3) Topography: <u>X</u> (Hilly) (Flat) (Level)	<u>Red sand + gravel</u>	<u>30'</u>	
(4) Purpose of Well: <u>Home use</u> (Domestic Irrigation Municipal, Industrial, Other)	<u>hard &amp; gravel</u>	<u>19'</u>	


Information upon completion of well:

- (1) Diameter 2 inches.  
(2) Total Depth 64 feet.  
(3) Water Level 4.5 feet below top of ground.  
(4) Cased to 64, Size 2  
(5) Screen: Size 1/4, Length 6'  
(6) Were any formations sealed against pollution?  
\_\_\_\_\_ yes, \_\_\_\_\_ no.

If YES depth of formation \_\_\_\_\_

Why \_\_\_\_\_

Drillers Remarks: \_\_\_\_\_

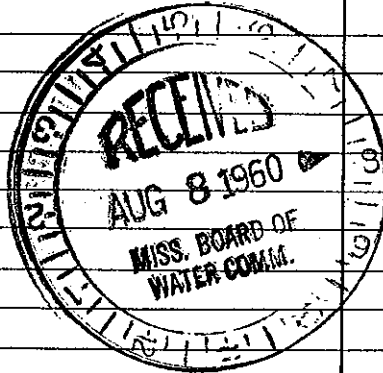

(Use Back Side)

4

Well. Miss

Mail this copy to Board of Water Commissioners 429 Miss. St. Jackson, Miss