

Desoto MISSISSIPPI BOARD OF WATER COMMISSIONERS

K 2088
5-15-65

WATER WELL DRILLERS LOG

Date: May 15, 1965, Driller: K. W. Miller County Desoto
(Name)

	Description & Color of Materials Sand, Clay, Red Clay, Shell, etc.	Thick- ness Feet	Depth Feet
(1) Owner of Land: <u>Clifton Land & Gin Co.</u> (Name) <u>Hernando, Miss.</u> (Address)	0 - 25 <u>Surface Clay</u>		25
(2) Location: <u>3/4</u> , <u>3/4</u> , Sec. <u>T. R.</u> <u>3</u> miles <u>S. W.</u> , of <u>Hernando</u> (distance) (direction) (Nearest Town)	25 - 45 <u>Blue Clay</u>		20
(3) Topography: <u>Flat</u> (Hilly) (Flat) (Level)	45 - 61 <u>Sand & Gravel</u>		16
(4) Purpose of Well: <u>Domestic</u> (Domestic Irrigation Municipal, Industrial, Other)	61 - 71 <u>Sand, Some fine Gravel</u>		10
	71 - 75 <u>Fine Gravel, Coarse Sand</u>		4
	75 - 97 <u>Coarse Gravel & Coarse Sand</u>		22


Information upon completion of well:

- (1) Diameter 4 inches.
- (2) Total Depth 97 feet.
- (3) Water Level 28 feet below top of ground.
- (4) Cased to 84', Size 4"
- (5) Screen: Size 2 1/2", Length 13
- (6) Were any formations sealed against pollution?
no yes, No no.

If YES depth of formation _____

Why _____

Drillers Remarks: _____

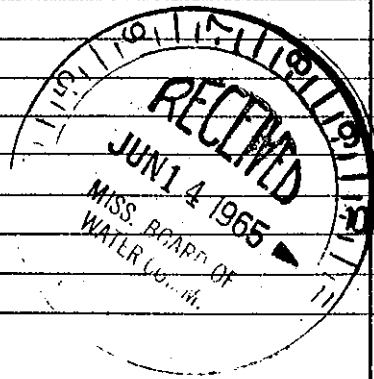

(Use Back Side)

Well No.

Mail this copy to Board of Water Commissioners 429 Miss. St. Jackson, Miss.