

DESOTO MISSISSIPPI BOARD OF WATER COMMISSIONERS

K 2009
6-1-65

WATER WELL DRILLERS LOG

Date: 6-1, 1965, Driller: Harris Bros. County Tate
Gerald Harris (Name)

(1) Owner of Land: Tom H. Milam
(Name)
Hernando
(Address)

(2) Location: 1/4, 1/4, Sec. 38
T R
miles of
(distance) (direction) (Nearest Town)

(3) Topography: (Hilly) (Flat) (Level)


(4) Purpose of Well: Domestic
(Domestic Irrigation
Municipal, Industrial, Other)

Description & Color of Materials Sand, Clay, Red Clay, Shell, etc.	Thick- ness Feet	Depth Feet
top soil	0	25
red sand & gravel	25	40
white clay	40	80
grey clay and fine sand	80	210
clay and sand strip	210	260
coarse white sand	260	280

Information upon completion of well:

- (1) Diameter 4 inches.
- (2) Total Depth 280 feet.
- (3) Water Level 120 feet below top of ground.
- (4) Cased to 266, Size 4"
- (5) Screen: Size 4", Length 14'
- (6) Were any formations sealed against pollution?
yes, no.

If YES depth of formation _____
Why _____
Drillers Remarks: _____

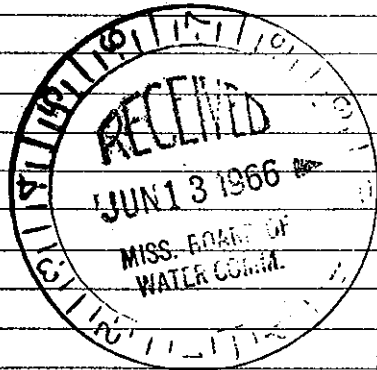

Well No.

(Use Back Side)

Mail this copy to Board of Water Commissioners 429 Miss. St. Jackson. Miss