

DESO TO
K 2017
3-27-76

MISSISSIPPI
BOARD OF WATER COMMISSIONERS
416 North State Street
15E Jackson, Mississippi 39201

WATER WELL DRILLERS LOG

3-27-1976
date well completed

Lab Smith Well Co.
firm name

Desoto
county well located

LANDOWNER:

Larry McEwen

Hernando, Ms

(mailing address)

WELL LOCATION:

sec. 30 T. 3 N. R. 8 E.
1 miles SW of Hernando
(distance) (direction) (nearest town)

WELL PURPOSE: Phone
(home, irrigation, municipal, industrial)

WELL COMPLETION DATA:

- (1) diameter (inches) 4
(2) total depth (feet) 180
(3) static water level (feet) 55 below
top of ground.
(4) casing plastic 180
(material) (depth)

10 If telescope see back.
(size)

- (5) screen 10 170
(length) (depth to top)

4" plastic
(size) (material)

- (6) pump 3/4 10
(HP) (yield gpm)

E lic.
(type power)

- (7) electric log no
(yes or no)

(organization running log)

- (8) how well bottom plugged plugged

DRILLERS REMARKS:

description of formations
encountered

from

to

top soil

0

5

red clay

5

30

shale

30

60

fine sand & clay


60

160

coarse sand

160

180

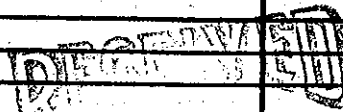

MAY 27 1976

MISS. BD. OF WATER COMMISSIONERS