


DeSoto MISSISSIPPI BOARD OF WATER COMMISSIONERS

L.  
5-29-61

WATER WELL DRILLERS LOG

Date: May 29, 19 61, Driller: Deep South Well Co. County DeSoto  
(Name)

(1) Owner of Land: <u>E. M. Evans</u> (Name)	Description & Color of Materials Sand, Clay, Red Clay, Shell, etc.	Thick- ness Feet	Depth Feet
<u>Hernando, Miss.</u> (Address)	<u>0-25 Surface clay</u>	<u>25</u>	
(2) Location: <u>1/4</u> , <u>1/4</u> , Sec. <u>T</u> <u>R</u> ,	<u>25-60 Sand &amp; gravel</u>	<u>35</u>	
<u>1 1/2</u> miles <u>S.E.</u> , of <u>Hernando</u> (distance) (direction) (Nearest Town)	<u>60-150 Blue clay</u>	<u>90</u>	
(3) Topography: <u>Flat</u> (Hilly) (Flat) (Level)	<u>150-220 Fine sand</u>	<u>70</u>	
(4) Purpose of Well: <u>Domestic</u> (Domestic Irrigation Municipal, Industrial, Other)	<u>220-230 Med. coarse sand</u>	<u>10</u>	
Information upon completion of well: *			
(1) Diameter <u>2 1/8</u> inches.			
(2) Total Depth <u>230</u> feet.			
(3) Water Level <u>139</u> feet below top of ground.			
(4) Cased to <u>None</u> , Size <u>None</u>			
(5) Screen: Size <u>1 1/8"</u> , Length <u>8 ft</u>			
(6) Were any formations sealed against pollution? <u>no</u> yes, <input checked="" type="checkbox"/> no.			
If YES depth of formation _____			
Why _____			
Drillers Remarks: _____			
_____			
_____			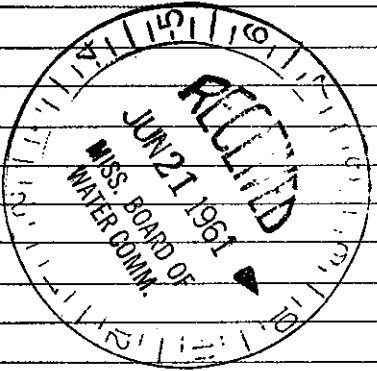
(Use Back Side)

Well No. MISS

Mail this copy to Board of Water Commissioners 429 Miss. St. Jackson, Miss