

UNERS

DEBOTO WATER WELL DRILLERS LOG

Date: 6-24-62, 1962, Driller: H/H Well Co County: DeWitt
A.C. Henderson (Name)

(1) Owner of Land:	Description & Color of Materials Sand, Clay, Red Clay, Shell, etc.	Thick- ness Feet	Depth Feet
<u>Charles Wells</u> (Name) <u>RFD Henderson miss.</u> (Address)	<u>Red clay</u>	<u>50</u>	<u>69</u>
(2) Location: <u>1/4</u> , <u>1/4</u> , Sec. <u>23 T. 1 R.</u>	<u>white clay</u>	<u>6</u>	
<u>7</u> miles <u>East, Henderson</u> of _____	<u>white sand</u>	<u>13</u>	
(3) Topography: <u>X</u>			
(4) Purpose of Well: <u>Home</u>			

Information upon completion of well:

(1) Diameter 2" inches.

(2) Total Depth 69' feet.

(3) Water Level 50 feet below top of ground.

(4) Cased to 63', Size 2"


(5) Screen: Size 1 1/4, Length 6'

(6) Were any formations sealed against pollution?
_____ yes, _____ no.

If YES depth of formation _____

Why _____

Drillers Remarks: _____

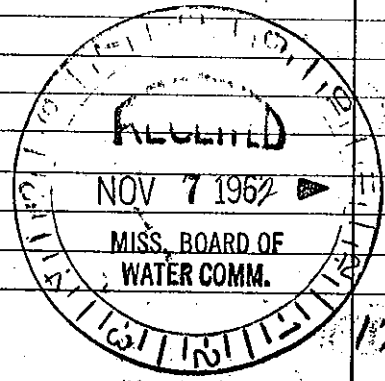

(Use Back Side)

Well No. 17

Retain this copy for your office files.