

Desoto MISSISSIPPI BOARD OF WATER COMMISSIONERS

SL

10-21-61

WATER WELL DRILLERS LOG

Date: Oct. 21, 1961, Driller: Deep South Well Co. County: Desoto
(Name)

(1) Owner of Land: <u>T. T. Fortinberry</u> (Name)	Description & Color of Materials Sand, Clay, Red Clay, Shell, etc.	Thick- ness Feet	Depth Feet
<u>R F D, Hernando, Miss.</u> (Address)	<u>0-27 Surface clay</u>	<u>27</u>	
<u>1/4, 1/4, Sec. 31 T 3 R 7,</u> <u>13 3 8</u>	<u>27-33 Gravel</u>	<u>6</u>	
<u>2</u> miles <u>North</u> , of <u>Hernando</u> (distance) (direction) (Nearest Town)	<u>33-50 White clay</u>	<u>17</u>	
<u>Flat</u> (Hilly) (Flat) (Level)	<u>50-84 Fine sand</u>	<u>34</u>	
<u>Domestic</u> (Domestic Irrigation Municipal, Industrial, Other)	<u>84-98 Coarse sand</u>	<u>14</u>	

Information upon completion of well:

(1) Diameter 2 1/2 inches.

(2) Total Depth 98 feet.

(3) Water Level 60 feet below top of ground.

(4) Cased to None, Size _____


(5) Screen: Size 1 1/8, Length 8 ft

(6) Were any formations sealed against pollution?
_____ yes, no no.

If YES depth of formation _____

Why _____

Drillers Remarks: _____

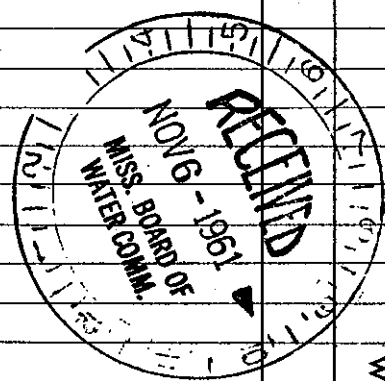

Well No.

(Use Back Side)

Mail this copy to Board of Water Commissioners 429 Miss. St. Jackson, Miss.