

DECATO

WATER WELL DRILLERS

2306


Date: 2-16-61, 1961, Driller: A. G. Henderson county Decato  
(Name)

(1) Owner of Land:	Description & Color of Materials Sand, Clay, Red Clay, Shell, etc.	Thick- ness Feet	Depth Feet
<u>Whitley Parramore</u> (Name) <u>Hernando miss.</u> (Address)	<u>80' Red Clay</u> <u>20' Sand</u> <u>47' White Sand</u>		<u>147</u>
(2) Location: <u>1/4</u> , <u>1/4</u> , Sec. <u>T</u> R. <u>R</u>			
<u>2</u> miles <u>S</u> , of <u>Hernando</u> (distance) (direction) (Nearest Town)			
(3) Topography: <u>X</u> (Hilly) (Flat) (Level)			
(4) Purpose of Well: <u>Home</u> (Domestic Irrigation Municipal, Industrial, Other)			

Information upon completion of well:

- (1) Diameter 2 inches.
- (2) Total Depth 147 feet.
- (3) Water Level 60 feet below top of ground.
- (4) Cased to 140', Size 2"
- (5) Screen: Size 1/4, Length 6'
- (6) Were any formations sealed against pollution?  
\_\_\_\_\_ yes, \_\_\_\_\_ no.

0052

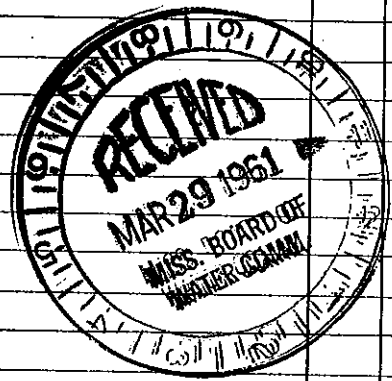

If YES depth of formation \_\_\_\_\_

Why \_\_\_\_\_

Drillers Remarks: \_\_\_\_\_

15 Well No.

(Use Back Side)

Retain this copy for your office files.