

MISSISSIPPI  
BOARD OF WATER COMMISSIONERS  
416 North State Street  
Jackson, Mississippi 39201

**CODED**

**CODED**

WATER WELL DRILLERS LOG

Robert E. Kately Co. Desoto

Desoto  
L-5  
-68  
US65

01872

date well completed 19 \_\_\_\_\_ firm name \_\_\_\_\_ county well located \_\_\_\_\_

LANDOWNER: Lawrence  
Hernando, Miss.

description of formations encountered	from	to
Buckshot & sand	0	23
sand	23	33
sand + gravel	33	50
Clay	50	151
sand	151	338
Sandy shale	338	350

(mailing address)


WELL LOCATION:  
sec. 18 T. 3 N. R. 7 E.  
(S) (W)  
\_\_\_\_\_ miles \_\_\_\_\_ in \_\_\_\_\_ town  
(distance) (direction) (nearest town)

WELL PURPOSE: Municipal  
(home, irrigation, municipal, industrial)

WELL COMPLETION DATA:

- diameter (inches) 10 x 6
- total depth (feet) 335
- static water level (feet) 160 <sup>below</sup> <sub>above</sub> top of ground
- casing W. St. 281'  
(material) (depth)  
10" if telescope see back.  
(size)
- screen 54' 281'  
" (length) (depth to top)  
6" st. steel  
(size) (material)
- pump 60 250  
(HP) (yield gpm)  
electric  
(type power)
- electric log yes  
(yes or no)  
U.S.G.S.  
(organization running log)
- how well bottom plugged BPU

**CODED**

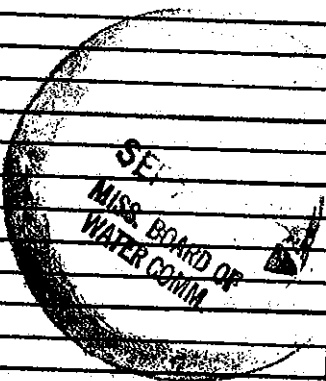

DRILLERS REMARKS: