

DeSoto  
L6  
11-12-68

MISSISSIPPI  
BOARD OF WATER COMMISSIONERS  
416 North State Street  
Jackson, Mississippi 39201

WATER WELL DRILLERS LOG

**CODED**

11-12 1968 Watson Co. DeSoto  
date well completed firm name county well located


LANDOWNER:	description of formations encountered	from	to
W. L. Reid, Jr. 1389 Farwell Rd	Surface clay	0	12
Memphis Tenn. (mailing address)	Sand + gravel	12	22

WELL LOCATION:	description of formations encountered	from	to
sec 36 T. 3 N R. 7 E 8 miles S. E. of Hernando	Red Sand	22	85
(distance) (direction) (nearest town)	White Sand med. Coarse	85	100

WELL PURPOSE:  
(home, irrigation, municipal, industrial)

WELL COMPLETION DATA:	description of formations encountered	from	to
(1) diameter (inches) 4"			
(2) total depth (feet) 98' 4"			
(3) static water level (feet) 69 below top of ground.			
(4) casing Plastic, 63' (material) (depth)			
(size) If telescope see back.			
(5) screen 6' (length) (depth to top)			
# R.B. 7025 Plastic (size) (material)			
(6) pump 1/2 (HP) (yield gpm)			
Submersible - Elec. (type power)			
(7) electric log (yes or no)			
(organization running log)			
(8) how well bottom plugged			

**CODED**

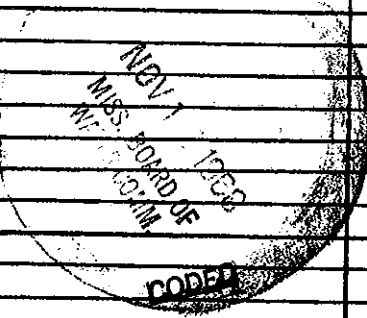

**CODED**

DRILLERS REMARKS: