

DeSoto
 0L14
 12-65
 GW 15079 ok Pat 703

MISSISSIPPI BOARD OF WATER COMMISSIONERS

WATER WELL DRILLERS LOG

CODED

Date: 12-10-, 1965, Driller: Layne-Central Co. County DeSoto
 (Name)

| (1) Owner of Land: | Description & Color of Materials Sand, Clay, Red Clay, Shell, etc. | Thick- ness Feet | Depth Feet |
|--|---|------------------------|---------------|
| <u>Belmont Road Water Assn.</u> (Name) | clay | 12 | 12 |
| <u>Hernando, Mississippi</u> (Address) | clay-gravel | 6 | 18 |
| (2) Location: <u>1/4, 20 1/4, Sec. 30 T 3R 7</u> | clay | 45 | 63 |
| <u>30</u> miles <u>5</u> of <u>W</u> (distance) (direction) (Nearest Town) | fine sand | 7 | 70 |
| (3) Topography: _____ (Hilly) (Flat) (Level) | clay | 80 | 150 |
| (4) Purpose of Well: <u>Municipal</u> (Domestic Irrigation Municipal, Industrial, Other) | sandy clay | 19 | 169 |
| | hard fine sand | 21 | 190 |
| | sand | 81 | 271 |
| | clay | 5 | 276 |

Information upon completion of well:


- (1) Diameter 8 inches.
 (2) Total Depth 276' 5" feet.
 (3) Water Level 130' feet below top of ground.
 (4) Cased to 234', Size 8"
 (5) Screen: Size 6", Length 36' 2"
 (6) Were any formations sealed against pollution?
 yes, no.

If YES depth of formation 234'

Why required

Drillers Remarks:

CODED

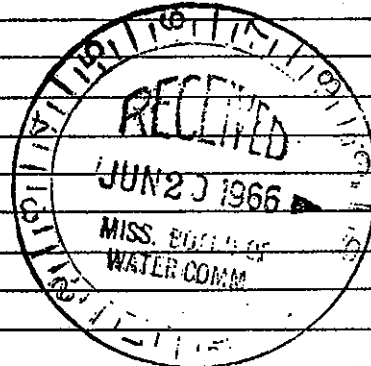

(Use Back Side)

Well No.

Mail this copy to Board of Water Commissioners 429 Miss. St. Jackson, Miss.