

Desoto

MISSISSIPPI BOARD OF WATER COMMISSIONERS

L25

7-15-60

WATER WELL DRILLERS LOG

4-301  
**CODED**

Date: 7/15, 1960, Driller: Geo. H. Hyde County: Desoto  
(Name)

(1) Owner of Land: <u>Mr. C.D. Weeks</u> (Name)	Description & Color of Materials Sand, Clay, Red Clay, Shell, etc.	Thick- ness Feet	Depth Feet
<u>Hernando.</u> (Address)	<u>Red Clay</u>	<u>30</u>	
(2) Location: <u>1/4, 1/4, Sec. 17 T. 3. R. 7.</u>	<u>Gravel</u>	<u>35</u>	
<u>2</u> miles <u>East</u> , of <u>Hernando</u> (distance) (direction) (Nearest Town)	<u>Blue mud</u>	<u>67</u>	
(3) Topography: <u>Hilly</u> (Hilly) (Flat) (Level)	<u>medium sand</u>	<u>177</u>	
(4) Purpose of Well: <u>Domestic</u> (Domestic Irrigation Municipal, Industrial, Other)	This well consists of 3 in p+R pipe. euripa cyl 6 slot, stainless steel strainer wrapped on copper - 21 feet 2 in pull back bit cyl + strainer. Coops wood rods 6 in Carlos pump 1 horse motor 22 gal tank -		


Information upon completion of well:

- (1) Diameter 3 inches.
- (2) Total Depth 179 feet.
- (3) Water Level 135 feet below top of ground.
- (4) Cased to 168, Size \_\_\_\_\_
- (5) Screen: Size 6 slot, Length 6 ft.
- (6) Were any formations sealed against pollution?  
\_\_\_\_\_ yes,  no.

If YES depth of formation \_\_\_\_\_

Why \_\_\_\_\_

Drillers Remarks: \_\_\_\_\_

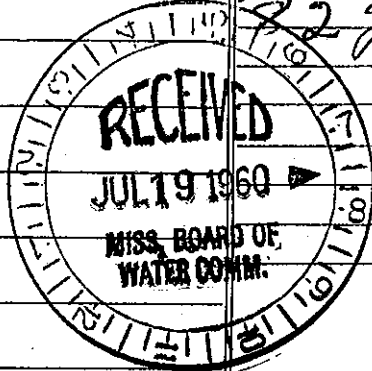

**CODED**

Well No. \_\_\_\_\_

(Use Back Side)

Mail this copy to Board of Water Commissioners 429 Miss. St. Jackson, Miss