

Desoto MISSISSIPPI BOARD OF WATER COMMISSIONERS

Kash

AL 26
7-21-60

WATER WELL DRILLERS LOG **CODED**


Date: 7-21, 1960 Driller: A.C. Henderson County: Desoto
(Name)

(1) Owner of Land	Description & Color of Materials Sand, Clay, Red Clay, Shell, etc.	Thick- ness Feet	Depth Feet
<u>Robert Bowers</u> (Name) <u>Hernando, Miss</u> (Address)	<u>white clay</u>	<u>84</u>	<u>192</u>
(2) Location: <u>1/4</u> , <u>1/4</u> , Sec. <u>30</u> , <u>T 3 R 7</u> <u>2</u> miles <u>S</u> of <u>Hernando</u> (distance) (direction) (Nearest Town)	<u>white sand & clay</u> <u>white sand & fine</u>	<u>45</u> <u>68</u>	
(3) Topography: <u>X</u> (Hilly) (Flat) (Level)			
(4) Purpose of Well: <u>Home use</u> (Domestic Irrigation Municipal, Industrial, Other)			

CODED

Information upon completion of well:

- (1) Diameter 2 1/2 inches.
- (2) Total Depth 192 feet.
- (3) Water Level 89 feet below top of ground.
- (4) Cased to 192, Size 4 1/2
- (5) Screen: Size 1 1/2, Length 6
- (6) Were any formations sealed against pollution?
_____ yes, X no.

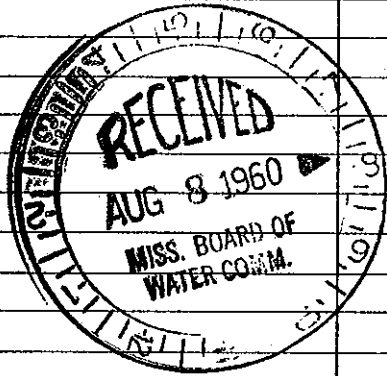

If YES depth of formation _____

Why _____

Drillers Remarks: _____

Well No. 1

(Use Back Side)

Mail this copy to Board of Water Commissioners 429 Miss. St. Jackson, Miss.