

DESOTO

L 28

11-1-60

WATER WELL DRILLERS LOG

L-300
CODED

Date: 11-1-60, Driller: C B Perry County: Desoto
(Name)

(1) Owner of Land: <u>J L Herbert</u> (Name) <u>Rt #2 Box 177A Hernando</u> (Address)	Description & Color of Materials Sand, Clay, Red Clay, Shell, etc.	Thick- ness Feet	Depth Feet
(2) Location: <u>1/4</u> , <u>1/4</u> , Sec. <u>10 T 3 R 7</u> <u>4</u> miles <u>East</u> of <u>Hernando</u> (distance) (direction) (Nearest Town)	<u>0-7' Red Clay</u>	<u>7</u>	
(3) Topography: <u>X</u> (Hilly) (Flat) (Level)	<u>7-8' Red sand</u>	<u>1</u>	
(4) Purpose of Well: <u>Domestic</u> (Domestic Irrigation Municipal, Industrial, Other)	<u>8-23' Gravel</u>	<u>15</u>	
	<u>23-30' white Clay</u>	<u>7</u>	
	<u>30-54' Blue Clay</u>	<u>24</u>	
	<u>54-109 white Clay</u>	<u>55</u>	
	<u>109-117 sandy Clay</u>	<u>8</u>	
	<u>117-196 fine white</u>	<u>79</u>	
	<u>sand (slappy)</u>		
	<u>with nipel,</u>		
	<u>chunks of white</u>		
	<u>clay (quick sand)</u>		
	<u>196-198 coarse</u>	<u>2</u>	
	<u>white sand</u>		
	<u>198-199 fine sand</u>		
	<u>199-200 white Clay</u>		
	<u>200-211 coarse</u>	<u>11</u>	
	<u>rice like material</u>		
	<u>bearing sand</u>		

Information upon completion of well:


- (1) Diameter 3 inches.
- (2) Total Depth 211 feet.
- (3) Water Level 67 feet below top of ground.
- (4) Cased to 205, Size 3
- (5) Screen: Size 2", Length 6'
- (6) Were any formations sealed against pollution?
X yes, no.

If YES depth of formation 205' to surface

Why General Practice

Drillers Remarks: Did not

drill to bottom of
sand, pumped
60 G.P.M. with
air test.

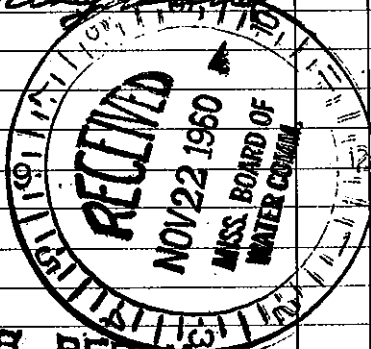

C. B. PERRY CO.
3102 SO. THIRD STREET
MEMPHIS 9, TENNESSEE

CODED

(Use Back Side)

211

Well No.
5

Mail this copy to Board of Water Commissioners 429 Miss. St. Jackson, Miss