

DeSoto

MISSISSIPPI BOARD OF WATER COMMISSIONERS

L-30  
5-18-61

WATER WELL DRILLERS LOG

**CODED**

Date: May 18, 19 61, Driller: Deep South Well Co. County DeSoto  
(Name)

(1) Owner of Land: <u>C. K. Dilworth</u> (Name)	Description & Color of Materials Sand, Clay, Red Clay, Shell, etc.	Thick- ness Feet	Depth Feet
<u>Hernando, Miss.</u> (Address)	<u>0-25 Surface clay</u>	<u>25</u>	
(2) Location: <u>1/4</u> , <u>1/4</u> , Sec. <u>7 T. 3R 7</u>	<u>25-45 Sand &amp; gravel</u>	<u>20</u>	
<u>1 1/2</u> miles <u>N.E.</u> , of <u>Hernando</u> (distance) (direction) (Nearest Town)	<u>45-60 White clay</u>	<u>15</u>	
(3) Topography: <u>Hilly</u> (Hilly) (Flat) (Level)	<u>60-100 Blue clay</u>	<u>40</u>	
(4) Purpose of Well: <u>Domestic</u> (Domestic Irrigation Municipal, Industrial, Other)	<u>100-160 Blue clay, stricks fine sand</u>	<u>60</u>	
	<u>160-276 Fine sand</u>	<u>116</u>	
	<u>276-286 Med. coarse sand</u>	<u>10</u>	
	<u>286-296 Coarse sand</u>	<u>10</u>	


Information upon completion of well:

- (1) Diameter 3 inches.
- (2) Total Depth 296 feet.
- (3) Water Level 138 feet below top of ground.
- (4) Cased to None, Size None.
- (5) Screen: Size 2", Length 8 ft.
- (6) Were any formations sealed against pollution?  
no yes, X no.

If YES depth of formation \_\_\_\_\_

Why \_\_\_\_\_

Drillers Remarks: \_\_\_\_\_

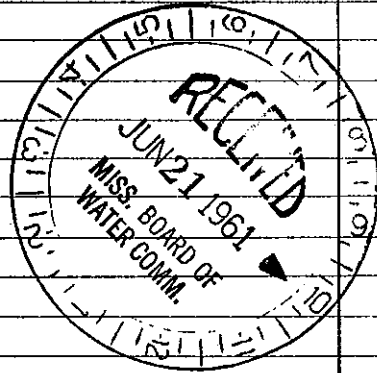

(Use Back Side)

Well No.

Mail this copy to Board of Water Commissioners 429 Miss. St. Jackson, Miss