

DESOTO MISSISSIPPI BOARD OF WATER COMMISSIONERS

L. 31
5-31-61

WATER WELL DRILLERS LOG

⁷
CODED

Date: May 31, 19 61, Driller: Deep South Well Co. County DeSoto
(Name)

	Description & Color of Materials Sand, Clay, Red Clay, Shell, etc.	Thick- ness Feet	Depth Feet
(1) Owner of Land: <u>Clarence H. Laughter</u> (Name)	0-15 <u>Surface clay</u>	15	
<u>Hernando, Miss.</u> (Address)	15-25 <u>White clay</u>	10	
(2) Location: <u>1/4</u> , <u>1/4</u> , Sec. <u>22 T. 3 R. 7</u>	25-35 <u>Sand, some gravel</u>	10	
<u>3</u> miles <u>East</u> , of <u>Hernando</u> (distance) (direction) (Nearest Town)	35-55 <u>Fine sand</u>	20	
(3) Topography: <u>Hilly</u> (Hilly) (Flat) (Level)	55-60 <u>Med. sand</u>	5	
(4) Purpose of Well: <u>Domestic</u> (Domestic Irrigation Municipal, Industrial, Other)	60-90 <u>Fine sand</u>	30	
	90-99 <u>Med. sand</u>	9	
	99-110 <u>Med. coarse sand</u>	11	
	110-122 <u>Coarse & med. coarse sand</u>	12	

Information upon completion of well:


- (1) Diameter 2 1/8 inches.
- (2) Total Depth 122 feet.
- (3) Water Level 55 feet below top of ground.
- (4) Cased to None, Size None.
- (5) Screen: Size 1 1/2", Length 8 ft.
- (6) Were any formations sealed against pollution?
no.

If YES depth of formation _____

Why _____

Drillers Remarks: _____

CODED

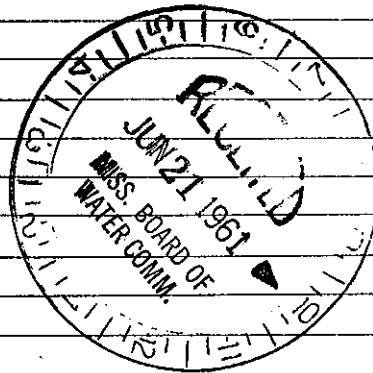

(Use Back Side)

Well No.

Mail this copy to Board of Water Commissioners 429 Miss. St. Jackson, Miss