

DeSoto MISSISSIPPI BOARD OF WATER COMMISSIONERS

L 33  
10-13-61

WATER WELL DRILLERS LOG

**CODED**

Date: Oct. 13, 19 61, Driller: Deep South Well Co. County DeSoto

(Name)

(1) Owner of Land: Walter Bolin  
(Name)  
Route 1, Hernando, Miss.  
(Address)

(2) Location: 1/4, 1/4, Sec. 28 T3R7,  
4 miles S.E. of Hernando  
(distance) (direction) (Nearest Town)

(3) Topography: Hilly  
(Hilly) (Flat) (Level)

(4) Purpose of Well: Domestic  
(Domestic Irrigation  
Municipal, Industrial, Other)

Description & Color of Materials Sand, Clay, Red Clay, Shell, etc.	Thick- ness Feet	Depth Feet
0-15 Surface clay	15	
15-45 Sticky white clay	30	
45-164 Blue clay	119	
164-188 Sand w/clay strks	24	
188-193 Fine sand	5	
193-199 Med. sand clay strks	6	
199-206 " " " "	7	
206-218 Med. sand	12	
218-224 " "	6	
224-227 " "	3	
227-237 Med. coarse sand	10	
237-251 Coarse & med. coarse	14	

Information upon completion of well:

(1) Diameter 4 inches.

(2) Total Depth 251 feet.

(3) Water Level 119 feet below top of ground.

(4) Cased to None, Size \_\_\_\_\_

(5) Screen: Size 2 1/8", Length 10 ft


(6) Were any formations sealed against pollution?  
\_\_\_\_\_ yes, no no.

If YES depth of formation \_\_\_\_\_

Why \_\_\_\_\_

Drillers Remarks: \_\_\_\_\_

**CODED**

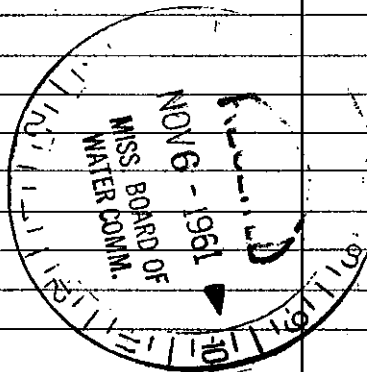

(Use Back Side)

Well No.

Mail this copy to Board of Water Commissioners 429 Miss. St. Jackson, Miss