

Desoto

Date 1-31-61, 1961, Driller: [Signature] County [Signature]  
10-30-61

**CODED**

(1) Owner of Land: _____ (Name)	Description & Color of Materials Sand, Clay, Red Clay, Shell, etc.	Thick- ness Feet	Depth Feet
<u>[Signature]</u> (Address)	<u>red sand clay</u>	<u>2</u>	<u>153</u>
(2) Location: <u>1/4, 1/4, Sec. 29 T3 R 7,</u> <u>_____ miles _____ of _____</u> (distance) (direction) (Nearest Town)	<u>hard sand of gravel</u> <u>white clay</u> <u>white sand</u>	<u>1</u> <u>50</u> <u>25</u>	
(3) Topography: _____ (Hilly) (Flat) (Level)			
(4) Purpose of Well: <u>21</u> (Domestic, Irrigation, Municipal, Industrial, Other)			


**CODED**

Information upon completion of well:

- (1) Diameter 2 inches.
- (2) Total Depth 153 feet.
- (3) Water Level 126 feet below top of ground.
- (4) Cased to 147, Size 2
- (5) Screen: Size 1/4, Length 6'
- (6) Were any formations sealed against pollution?  
\_\_\_\_\_ yes, \_\_\_\_\_ no.

If YES depth of formation \_\_\_\_\_  
Why \_\_\_\_\_  
Drillers Remarks: \_\_\_\_\_

0057

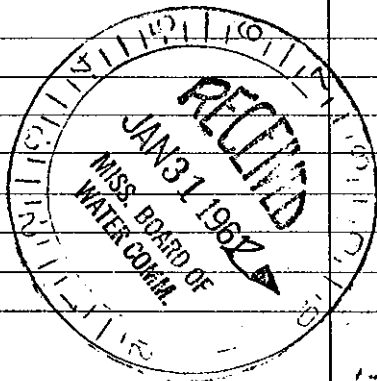

(Use Back Side)

Well No. 17

Retain this copy for your office files.