

Desoto

MISSISSIPPI BOARD OF WATER COMMISSIONERS

AL 35

4-3-62

WATER WELL DRILLERS LOG

CODED

Date: 4-3, 1962, Driller: H H Well Co County Desoto

(Name)


A. C. Henderson

(1) Owner of Land:	Description & Color of Materials Sand, Clay, Red Clay, Shell, etc.	Thick- ness Feet	Depth Feet
E. B. Mosby (Name)	white clay	70'	147
Lane Miss. (Address)	streaky clay + gravel	25'	
(2) Location: 5 1/4, 1/4, Sec. 6 T. 4 R. 7	fine sand	30'	
South 5 1/4 miles Herron's of Miss. (Distance) (Direction) (Nearest Town)	white sand	22'	
(3) Topography: X (Hilly) (Flat) (Level)			147
(4) Purpose of Well: Home + farm (Domestic Irrigation, Municipal, Industrial, Other)	Rod Pump		

Information upon completion of well:

- (1) Diameter 3 inches.
- (2) Total Depth 147 feet.
- (3) Water level 70' feet below top of ground.
- (4) Cased to 135, Size 3
- (5) Screen: Size 2", Length 6' with pullbocks 6 long
- (6) Were any formations sealed against pollution?
_____ yes, _____ no.

CODED

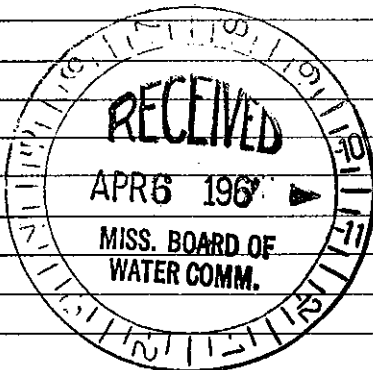

(Use Back Side)

23

Well No.

Mail this copy to Board of Water Commissioners 429 Miss. St. Jackson, Miss.