

Desoto
L36

8-4-62

DRILLERS LOG

Date: 8-4, 1962, Driller: H+H Well Co. County: **CODED**

Name: *Agnes Henderson*

(1) Owner of Land:	Description & Color of Materials Sand, Clay, Red Clay, Shell, etc.	Thick- ness Feet	Depth Feet
<i>Charlie Chambers</i> (Name) <i>R.F.P. Henderson</i> (Address)	<i>Red clay</i>		70
(2) Location: $\frac{1}{4}$, $\frac{1}{4}$, Sec. <i>14</i> 15T 3R7 <i>3</i> miles <i>East Henderson</i> of (distance) (direction) (Nearest Town)	<i>Red clay</i>	30	
	<i>Red sand</i>	10	
	<i>White clay</i>	10	
	<i>Sand</i>	20	
(3) Topography: <i>X</i> (Hilly) (Flat) (Level)			
(4) Purpose of Well: <i>Home</i> (Domestic Irrigation Municipal, Industrial, Other)			


CODED

Information upon completion of well:

- (1) Diameter: ~~4~~ *2-1/2* inches. *2- plaster*
- (2) Total Depth: *70* feet.
- (3) Water Level: *55* feet below top of ground.
- (4) Cased to: *60*, Size: *2"*
- (5) Screen: Size: *1 1/4*, Length: *5' with pull back*
- (6) Were any formations sealed against pollution?
_____ yes, _____ no.

Jet Pump
5 G.P.M.

If YES depth of formation _____
Why _____
Drillers Remarks: _____

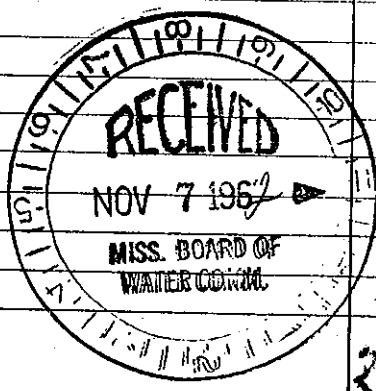

20

Well No.

(Use Back Side)

Retain this copy for your office files.