

DeSoto MISSISSIPPI BOARD OF WATER COMMISSIONERS

L 37
9-4-62

WATER WELL DRILLERS LOG

CODED

Date: Sept. 4, 1962, Driller: Deep South Well Co. County DeSoto
(Name)

(1) Owner of Land: Ollie J. Davis
(Name)
R F D, Hernando, Miss.
(Address)

(2) Location: 1/4, 1/4, Sec. 12 T. 3R,
1/2 1/2
3 miles West, of Hernando,
(distance) (direction) (Nearest Town)

(3) Topography: Flat
(Hilly) (Flat) (Level)

(4) Purpose of Well: Domestic
(Domestic Irrigation
Municipal, Industrial, Other)

Description & Color of Materials Sand, Clay, Red Clay, Shell, etc.	Thick- ness Feet	Depth Feet
0-25 Surface clay	25	
25-26 Hard rock	1	
26-27 Gravel	1	
27-29 Hard rock	2	
29-110 Blue clay	81	
110-125 Sandy blue clay	15	
125-163 Fine sand	38	
163-170 Med. fine sand	7	
170-195 Sandy blue clay	25	
195-208 Coarse and med. coarse sand	13	

Information upon completion of well:

(1) Diameter 2 1/2 inches.

(2) Total Depth 208 feet.

(3) Water Level 123 feet below top of ground.

(4) Cased to None, Size _____


(5) Screen: Size 1 1/2, Length 8 ft

(6) Were any formations sealed against pollution?
_____ yes, No no.

If YES depth of formation _____

Why _____

Drillers Remarks: _____

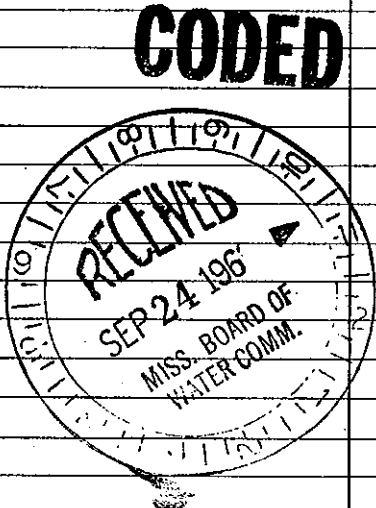

(Use Back Side)

Well No.

Mail this copy to Board of Water Commissioners 429 Miss. St. Jackson, Miss.