

DeSoto MISSISSIPPI BOARD OF WATER COMMISSIONERS

L 39

3-20-65 WATER WELL DRILLERS LOG

CODED

Date: 3-20, 1965, Driller: Harris Bros. County _____
(Name)

(1) Owner of Land:	Description & Color of Materials Sand, Clay, Red Clay, Shell, etc.	Thick- ness Feet	Depth Feet
(Name) <u>Hewart Scruggs</u> (Address) <u>Alexanders, Miss.</u>	<u>top soil</u>	<u>0</u>	<u>20</u>
	<u>gray clay</u>	<u>20</u>	<u>80</u>
(2) Location: _____ 1/4, _____ 1/4, Sec. <u>30</u> T <u>3</u> R <u>7</u>	<u>red sand & clay</u>	<u>80</u>	<u>140</u>
	<u>coarse white sand</u>	<u>140</u>	<u>160</u>
_____ miles _____ of _____ (distance) (direction) (Nearest Town)			
(3) Topography: _____ (Hilly) (Flat) (Level)			
(4) Purpose of Well: _____ (Domestic Irrigation Municipal, Industrial, Other)			

CODED


Information upon completion of well:

- (1) Diameter 4 inches.
- (2) Total Depth _____ feet.
- (3) Water Level 120 feet below top of ground.
- (4) Cased to 113, Size 4"
- (5) Screen: Size 4", Length 7'
- (6) Were any formations sealed against pollution?
_____ yes, _____ no.

If YES depth of formation _____

Why _____

Drillers Remarks: _____

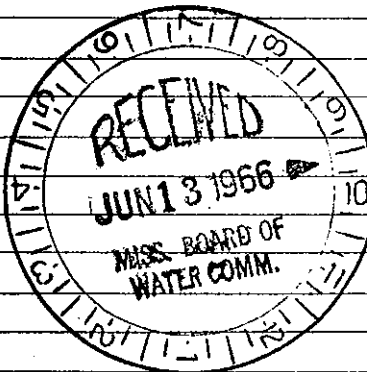

Well No.

(Use Back Side)

Mail this copy to Board of Water Commissioners 429 Miss. St. Jackson, Miss.