

Desoto MISSISSIPPI BOARD OF WATER COMMISSIONERS


L 41
7-31-65

WATER WELL DRILLERS LOG

CODED

Date: July 31, 19 65, Driller: Kenneth W. Miller County Desoto
(Name)

	Description & Color of Materials Sand, Clay, Red Clay, Shell, etc.	Thick- ness Feet	Depth Feet
(1) Owner of Land: <u>Banks & Co.</u> (Name) <u>Hernando, Miss.</u> (Address)	0-14 Surface Clay	14	
(2) Location: <u>1/4</u> , <u>1/4</u> , Sec. <u>13</u> T <u>3</u> R <u>7</u> , <u>6</u> miles <u>E</u> of <u>Hernando</u> , (distance) (direction) (Nearest Town)	14-132 Fine Sand	118	
(3) Topography: <u>Flat</u> (Hilly) (Flat) (Level)	132-147 Med. Fine Sand	15	
(4) Purpose of Well: <u>Domestic</u> (Domestic Irrigation Municipal, Industrial, Other)	147-156 Coarse & med. Coarse Sand	9	
Information upon completion of well:			
(1) Diameter <u>2 1/8</u> inches.	CODED		
(2) Total Depth <u>156</u> feet.			
(3) Water level 22 <u>28</u> feet below top of ground.			
(4) Cased to <u>149 ft.</u> , Size <u>2 1/8"</u>			
(5) Screen: Size <u>1 1/8"</u> , Length <u>7 ft.</u>			
(6) Were any formations sealed against pollution? <u>no</u> yes, <u>no</u> no.			
If YES depth of formation _____			
Why _____			
Drillers Remarks: _____			

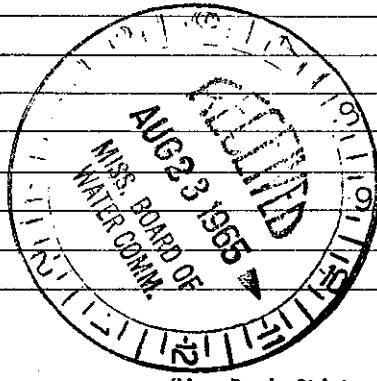

(Use Back Side)

Well No.

Mail this copy to Board of Water Commissioners 429 Miss. St. Jackson, Miss