

Oesoto

QL 42

10-65

MISSISSIPPI BOARD OF WATER COMMISSIONERS

CODED

WATER WELL DRILLERS LOG

Date: 10 -, 1965, Driller: Harris Bros. County, Missouri
(When well drilled) (Name) (Where well is located)

(1) Owner of Land:	Description & Color of Materials Sand, Clay, Red Clay, Shell, etc.	Thick- ness Feet	Depth Feet
<u>Mary G. Evans</u> (Name) <u>Hernando, Miss.</u> (Address)	<u>top soil</u>	<u>0</u>	<u>20</u>
	<u>gravel</u>	<u>20</u>	<u>60</u>
	<u>gray clay</u>	<u>60</u>	<u>140</u>
(2) Location: <u>1/4</u> , <u>1/4</u> , Sec. <u>20</u> T <u>3</u> R <u>7</u> , _____ miles _____ of _____ (distance) (direction) (Nearest Town)	<u>clay & sand</u>	<u>140</u>	<u>170</u>
	<u>coarse white sand</u>	<u>170</u>	<u>190</u>
(3) Topography: _____ (Hilly) (Flat) (Level)	CODED		
(4) Purpose of Well: _____ (Domestic Irrigation Municipal, Industrial, Other)			

Information upon completion of well:

- (1) Diameter 4 inches.
- (2) Total Depth 190 feet.
- (3) Water Level 120 feet below top of ground.
- (4) Cased to 176', Size 4"
- (5) Screen: Size 4", Length 21 7'
- (6) Were any formations sealed against pollution?
_____ yes, _____ no.

If YES depth of formation _____


Why _____

Drillers Remarks: _____

Yield in gpm: 10

Size pump: 3/4

Type power: electric

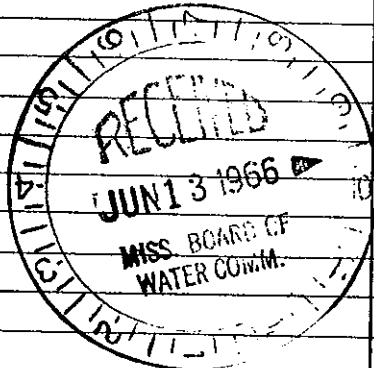

Mail this copy to Board of Water Commissioners 429 Miss. St. Jackson, Miss.