

State Well Report

Part 1 - Driller's Log

Mississippi Department of Environmental Quality
Office of Land and Water Resources
P.O. Box 10631
Jackson, MS 39289-0631
(601)961-5210
(601)354-6938 (fax)

County: Desoto
 Permit #: _____
 Driller: Jones W. Mason
 Date drilling completed: 1-29-07

For Office Use Only:

Aquifer: _____
 Well #: L-105
 L. S. Elevation: _____
 E-log #: _____

State Law requires that this report be prepared by the license holder responsible for the work and filed with the Department at the above address within 30 days of completion of drilling of the well or borehole.

| Information on Well Owner <small>(Landowner if borehole is not for a water well)</small> | Well or Borehole Location |
|---|--|
| Owner Name: <u>Robert Brintstone</u> | Latitude: <u>34° 48' 10.8"</u> Longitude: <u>89° 58' 01.27"</u> |
| Mailing Address: <u>3990 Mcinguale</u> | Method of Lat/Long (circle one): <u>Hand-held GPS</u> Conventional Survey, <u>01</u> |
| <u>Hernando</u> MS <u>38632</u> | USGS quad: <u>NE 1/4 NW 1/4 Sec 29 Twn 3S Rng 7W</u> |
| City State Zip Code | Distance <u>1.14</u> Miles Direction <u>SE</u> of Nearest Town <u>Hernando</u> |
| Telephone No. <u>(901) 351-8118</u> | |

Well / Borehole Data

Date drilling started: 1-29-07 Date drilling completed: 1-29-07 Hole depth: 230' Hole diameter: 6 3/4"

Location of the source of any surface water used for drilling: NA

Method of dosing and volume of Chlorine used in drilling and development: NA

Logs run (circle all applicable): No log run Electric Gamma Ray Density Sonic Neutron Other: _____

Name of organization running log(s): NA

Purpose of borehole (check one): Water Well Geotechnical/Geological Investigation Ground Source Heat Pump _____

Seismic Survey _____ Other (describe) _____

If drilling is not related to water well construction, skip the remainder of this block

Purpose of Well (check one): Home Industrial _____ Public Supply _____ Irrigation _____ Fish Culture _____ Other: _____

If a flowing well, method of flow regulation: Valve NA Other (describe) _____

Static Water Level: 126 feet above or below (circle one) land surface Date measured: 1-30-07

Method of Measurement (circle one) steel tape electric tape air line other: String/weight

Well depth: 230' Well grouted to a depth of 10 feet Type of grout (circle one): Neat Cement Bentonite Mix

Casing length: 210 feet Casing diameter: 4 inches Type of casing: pvc

Screen length: 20 feet Screen diameter: 4 inches Type of screen: pvc

Screen slot size: .010 inches Setting depth: From 210 feet to 230 feet

Type of completion (circle all applicable): Gravel packed Underreamed Telescoped Open hole Natural Development

Other (describe): NA


Top of lap pipe or reduction in casing: NA feet. ***If telescoped or more than one screen, describe on next page***

Form: OLWR-SWR-1A

RECEIVED
 FEB 26 2007
 BY: OLWR

The sketch below only required for water wells

If well telescopes, show depths on sketch.

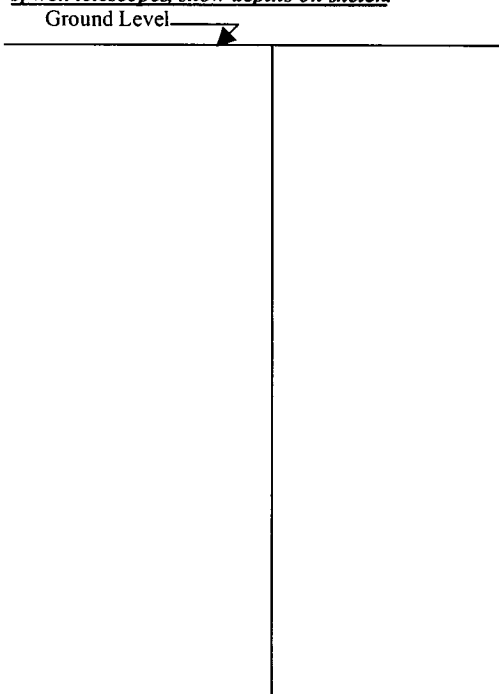


Description of formations encountered must be provided for all wells and boreholes, unless specifically exempted by regulations

| Description of Formations Encountered | From (depth) | To (depth) |
|---------------------------------------|--------------|------------|
| Clay dirt | Ground Level | 30 |
| Gravel | 30 | 60 |
| Blue clay | 60 | 120 |
| white sand | 120 | 230 |
| | | |
| | | |
If more than one screen, show location of each on sketch

Sketch the property layout and include the following: 1) the well location; 2) any permanent structures on the property that may aid in locating the well; 3) any roads, power lines, or other items that may aid in locating the property and the well; 4) a north arrow.

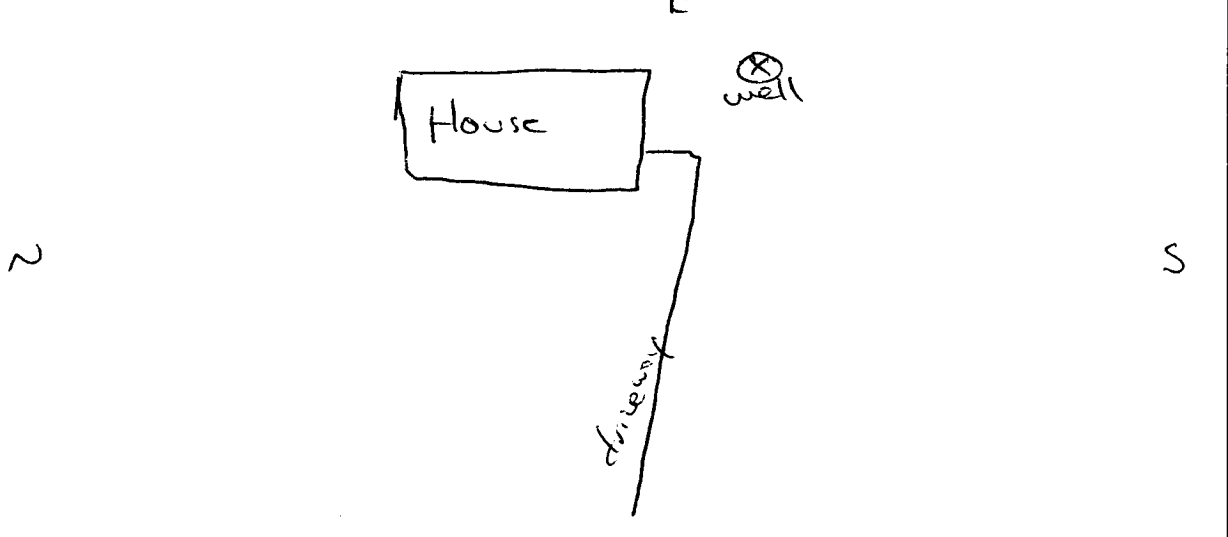

Landowner Name: Robert Brinkstone W

Form: OLWR-SWR-1A

I certify that the well/borehole was drilled, constructed, and completed in accordance with all applicable requirements of the Mississippi Department of Environmental Quality and the Mississippi Department of Health regulations, if applicable, and state laws.

Jones W. Mason 0-620 2-21-07
Print Name of Responsible Licensee and License No. Date

Jones W. Mason
Signature of Licensee

RECEIVED
FEB 26 2007
BY: OLWR

STATE WELL REPORT

Part 2

Pump Installer's Completion Report
 Mississippi Department of Environmental Quality
 Office of Land and Water Resources
 P.O. Box 10631
 Jackson, MS 39289-0631
 (601)961-5210
 (601)354-6938 (fax)

County: Desoto
 Permit #: _____
 Driller: Jones W. Mason
 Date completed: 1-30-07
Copy information from block on Part 1

For Office Use Only:

Aquifer: _____
 Well #: L-105
 Elevation: _____

This part of the report must be completed by a licensed water well contractor or a licensed pump installer. A copy of Part 1 of the report must be attached and both parts filed with the Department at the above address within 30 days of well completion.

| Well Owner Information | Well Location |
|--|---|
| Owner Name: <u>Robert Brinkstone</u> | Latitude: <u>34.48.108</u> Longitude: <u>89.58.027</u> |
| Mailing Address: <u>3990 McInquale</u> | Method of Lat/Long (check one): Conventional Survey _____ |
| <u>Hernando MS 38632</u> | USGS quad _____, Hand-held GPS <input checked="" type="checkbox"/> , Survey-grade GPS _____ |
| City State Zip Code | <u>NE 1/4 NW 1/4 Sec 29 T 35 R 7W</u> |
| Telephone No. <u>(901) 351-8118</u> | Distance Direction Nearest Town |
| | <u>1.14 Miles SE of Hernando</u> |

| Pump Type Circle one | Power Type Circle one |
|--|--|
| Air Lift Jet <input type="checkbox"/> Submersible <input checked="" type="checkbox"/> | Diesel Engine Gasoline Engine Natural Gas |
| Bucket Piston Turbine | Electric Motor <input checked="" type="checkbox"/> Hand Tractor PTO |
| Centrifugal Rotary Flowing Well | Windmill Other (specify): _____ |
| Other (specify): _____ | Horse Power Rating of Motor: <u>1 1/2</u> |
| Date Pump Installed: <u>1-30-07</u> | Setting Depth: <u>160</u> feet |
| Rated Pump Capacity: <u>20</u> Gallons Per Minute | Number of Stages: <u>14</u> |

| Pump Test Data | Method of Measuring Water Level Circle one |
|--|---|
| Date Well Tested: <u>1-30-07</u> | Air Line Electric Measuring Line Steel Tape |
| Static Water Level (A): <u>126</u> Feet Below Land Surface | Other (specify): <u>String weight</u> |
| Pumping Water Level (B): <u>NA</u> Feet Below Land Surface | For flowing well, measured shut in head: <u>NA</u> feet |
| Drawdown [(B) - (A)]: <u>NA</u> Feet Below Land Surface | Well yielded <u>20</u> GPM with a drawdown of |
| Test Pumping Rate: <u>20</u> Gallons Per Minute | <u>NA</u> feet after <u>24</u> hours of pumping |
| Duration of Pump Test (minimum 4 hours): <u>24</u> hours | |

I HEREBY CERTIFY that the above statements are true to the best of my knowledge.

Jones W. Mason 0-620
 Print Name of Pump Installer and License No. (if applicable)

Jones W. Mason
 Signature of Pump Installer

RECEIVED
 FEB 26 2007
 BY: OLWR