

County: DeSoto
 Permit #: _____
 Driller: E. LARGTOK &
 Date drilling completed: 6-13-07

State Well Report Part 1 - Driller's Log

Mississippi Department of Environmental Quality
 Office of Land and Water Resources
 P.O. Box 10631
 Jackson, MS 39289-0631
 (601)961-5210
 (601)354-6938 (fax)

For Office Use Only:
 Aquifer: _____
 Well #: L-107
 L. S. Elevation: _____
 E-log #: _____

State Law requires that this report be prepared by the license holder responsible for the work and filed with the Department at the above address within 30 days of completion of drilling of the well or borehole.

| | |
|--|---|
| <p>Information on Well Owner <i>(Landowner if borehole is not for a water well)</i></p> <p>Owner Name: <u>Don Qwan</u> Mailing Address: <u>SINGLETREE</u> <u>NEARNADO MS</u> City State Zip Code Telephone No. () _____</p> | <p>Well or Borehole Location</p> <p>Latitude: _____ Longitude: _____ Method of Lat/Long (circle one): <u>Conventional Survey</u> USGS quad, Hand-held GPS, Survey-grade GPS _____ 1/4 _____ 1/4 Sec <u>7</u> Twn <u>39</u> Rng <u>7W</u> Distance Direction Nearest Town <u>2</u> Miles <u>N</u> of <u>NEARNADO</u></p> |
|--|---|

Well / Borehole Data

Date drilling started: 6-12-07 Date drilling completed: 6-13-07 Hole depth: 270 Hole diameter: 6 7/8

Location of the source of any surface water used for drilling: Home Well
 Method of dosing and volume of Chlorine used in drilling and development: 2 GAL CHLOR

Logs run (circle all applicable): No log run Electric Gamma Ray Density Sonic Neutron Other: _____
 Name of organization running log(s): _____
 (Attach copy of log to this report)

Purpose of borehole (check one): Water Well Geotechnical/Geological Investigation _____ Ground Source Heat Pump _____
 Seismic Survey _____ Other (describe) _____
If drilling is not related to water well construction, skip the remainder of this block

Purpose of Well (check one): Home Industrial _____ Public Supply _____ Irrigation _____ Fish Culture _____ Other: _____

If a flowing well, method of flow regulation: Valve _____ Other (describe) _____

Static Water Level: 119 feet above or below (circle one) land surface Date measured: 6-13-07

Method of Measurement (circle one) steel tape electric tape air line other: _____

Well depth: 270 Well grouted to a depth of 10 feet Type of grout (circle one): Neat Cement Bentonite Mix

Casing length: 20 feet Casing diameter: 4 inches Type of casing: PVC

Screen length: 10 feet Screen diameter: 4 inches Type of screen: SLOT & PVC

Screen slot size: .013 inches Setting depth: From 200 feet to 210 feet

Type of completion (circle all applicable): Gravel packed Underreamed Telescoped Open hole Natural Development
 Other (describe): _____

Top of lap pipe or reduction in casing: None feet. *If telescoped or more than one screen, describe on next page*

RECEIVED

JUL 09 2007

BY: OLWR

STATE WELL REPORT

Part 2

Pump Installer's Completion Report
 Mississippi Department of Environmental Quality
 Office of Land and Water Resources
 P.O. Box 10631
 Jackson, MS 39289-0631
 (601)961-5210
 (601)354-6938 (fax)

For Office Use Only:

Aquifer: _____
 Well #: L-107
 Elevation: _____

County: DeSoto
 Permit #: _____
 Driller: F. LANGFORD
 Date completed: 6-13-07
Copy information from block on Part 1

This part of the report must be completed by a licensed water well contractor or a licensed pump installer. A copy of Part 1 of the report must be attached and both parts filed with the Department at the above address within 30 days of well completion.

| Well Owner Information | Well Location |
|-----------------------------------|--|
| Owner Name: <u>NON GRANT</u> | Latitude: _____ Longitude: _____ |
| Mailing Address: <u>SING TREE</u> | Method of Lat/Long (check one): <u>Conventional Survey</u> |
| <u>HERNANDO MS</u> | USGS quad _____, Hand-held GPS _____, Survey-grade GPS _____ |
| City State Zip Code | _____ 1/4 _____ 1/4 Sec <u>17</u> T <u>39</u> R <u>7W</u> |
| Telephone No. () _____ | Distance Direction Nearest Town |
| | <u>2</u> Miles <u>N</u> of <u>HERNANDO</u> |

| Pump Type Circle one | Power Type Circle one |
|---|---|
| Air Lift Jet <u>Submersible</u> | Diesel Engine Gasoline Engine Natural Gas |
| Bucket Piston Turbine | <u>Electric Motor</u> Hand Tractor PTO |
| Centrifugal Rotary Flowing Well | Windmill Other (specify): _____ |
| Other (specify): _____ | Horse Power Rating of Motor: <u>1 1/2</u> |
| Date Pump Installed: <u>6-13-07</u> | Setting Depth: <u>160</u> feet |
| Rated Pump Capacity: <u>20</u> Gallons Per Minute | Number of Stages: <u>12</u> |

| Pump Test Data | Method of Measuring Water Level Circle one |
|---|---|
| Date Well Tested: <u>6-13-07</u> | Air Line Electric Measuring Line <u>Steel Tape</u> |
| Static Water Level (A): <u>115</u> Feet Below Land Surface | Other (specify): _____ |
| Pumping Water Level (B): <u>115</u> Feet Below Land Surface | For flowing well, measured shut in head: _____ feet |
| Drawdown [(B) - (A)]: <u>5</u> Feet Below Land Surface | Well yielded <u>20 +</u> GPM with a drawdown of |
| Test Pumping Rate: <u>20 +</u> Gallons Per Minute | <u>5</u> feet after <u>1 1/2</u> hours of pumping |
| Duration of Pump Test (minimum 4 hours): <u>1 1/2</u> hours | |

I HEREBY CERTIFY that the above statements are true to the best of my knowledge.

FRANK LANGFORD 0-622
 Print Name of Pump Installer and License No. (if applicable)

Frank Langford
 Signature of Pump Installer

RECEIVED


JUL 09 2007

BY: OLWR

The sketch below only required for water wells

If well telescopes, show depths on sketch.

Ground Level →

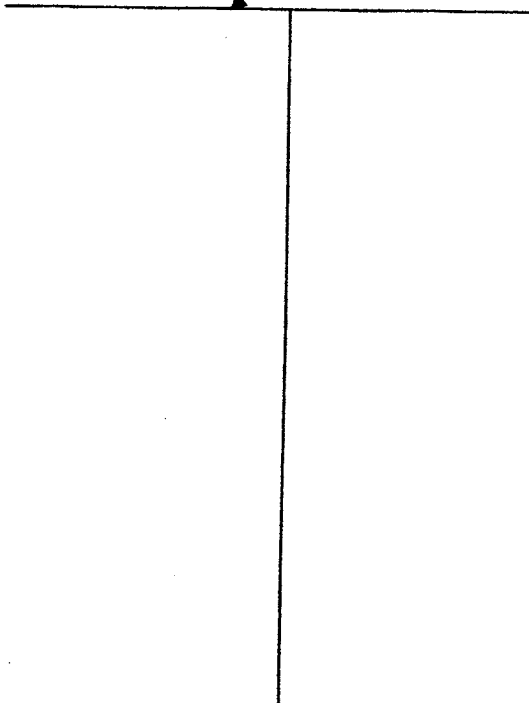


Description of formations encountered must be provided for all wells and boreholes, unless specifically exempted by regulations

| Description of Formations Encountered | From (depth) Ground Level | To (depth) |
|---------------------------------------|------------------------------|------------|
| DIAT | 0 | 20 |
| GRAVEL | 20 | 60 |
| GRAVEL | 60 | 100 |
| CLAY | 100 | 200 |
| SAND | 200 | 270 |
| | | |
| | | |
If more than one screen, show location of each on sketch

Sketch the property layout and include the following: 1) the well location; 2) any permanent structures on the property that may aid in locating the well; 3) any roads, power lines, or other items that may aid in locating the property and the well; 4) a north arrow.

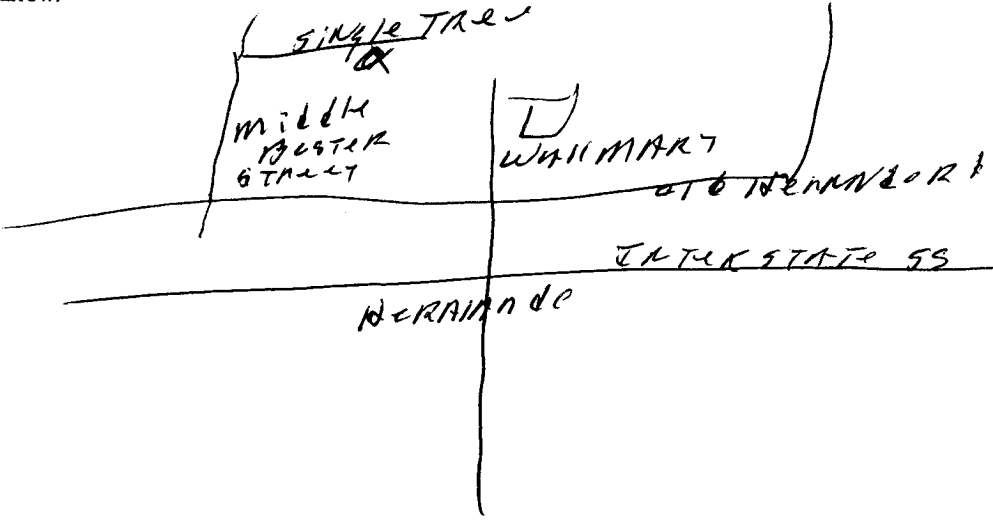

Landowner Name: DON BRANT

I certify that the well/borehole was drilled, constructed, and completed in accordance with all applicable requirements of the Mississippi Department of Environmental Quality and the Mississippi Department of Health regulations, if applicable, and state laws.

FRANK LANGFORD 0-622

6-13-07

Frank Langford

RECEIVED

JUL 09 2007

BY: OLWR

Print Name of Responsible Licensee and License No.

Date

Signature of Licensee