
County: Desoto	State Well Repo Part 1 – Driller's L	Eta Office Use Only
	Mississippi Department of Environ	mental Quality Aquifer:
Permit #:	Office of Land and Water R	esources $Well #: L - / 20$
Driller: Jacs W. Nosan	P.O. Box 10631 Jackson, MS 39289-06	
Date drilling completed: $4 - 36 - 08$	(601)961-5210	
	(601)354-6938 (fax)	
Department at the above address	within 30 days of completion of dr	responsible for the work and filed with the illing of the well or borehole.
Information on Well (Landowner if borehole is not fo		Well or Borehole Location
	Latitude:	<u>34° 50',541</u> " Longitude: <u>C89 57 ' 24</u>
Owner Name Bob Hissin both	CM Method of I	34° 50'541" Longitude: 089'57' 24 32 Lat/Long (circle one): Conventional Survey,
Mailing Address: 1224 Joy6	rd.	
		quad, Hand-held GPS Survey-grade GPS NW $\frac{1}{2}$ /4 Sec <u><u></u> Twn <u>3</u> Rng 7ω</u>
Hereit	38/037 12 1/3	W 1/4 Sec Twn SS Rng Iw
Hernendo My City Star	te Zip Code Distance	Direction Nearest Town
Telephone No. (901) 216 - 6-		liles Sw of Bright
	Well / Borehole Data	
Date drilling started: 4-36-08 Date dri	illing completed: 4-36-08 Hole de	pth: $\frac{345'}{1000}$ Hole diameter: $\frac{63}{4}$
Location of the source of any surface wate		
Method of dosing and volume of Chloring		4
Logs run (circle all applicable). No log run Name of organization running log(s):	Electric Gamma Ray Density S	onic Neutron Other:
Purpose of borehole (check one): Water W	_	
r urpose of borenoie (check one). water w	en Geolechinical/Geological investi	gation Ground Source Heat Pump
	Survey Other (describe) to water well construction, skip the rea	maindar of this block
		Fish Culture Other:
If a flowing well, method of flow regulatio	n: Valve <u>M</u> Other (describe)
Static Water Level: <u>(00</u> feet ab	ove or below (circle one) land surface	Date measured: $5 - 17 - 0c^{P}$
		other: String Weight.
Well depth: 245 Well grouted to a de	pth of <u>50</u> feet Type of grout (circ	le one): Neat Cement Bentonite Mix
wen depuit. O () wen glouted to a de		
	g diameter: <u> </u>	
Casing length: <u>225</u> feet Casir	ng diameter: <u>4</u> inches	Type of casing:
Casing length: <u> </u>	en diameter: <u> </u>	Type of casing:
Casing length: <u> </u>	en diameter: inches Setting depth: From	Type of casing:
Casing length: <u>225</u> feet Casir Screen length: <u>30</u> feet Scree Screen slot size: <u>, 010</u> inches	en diameter: inches Setting depth: From Gravel packed Underreamed Te	Type of casing: Type of screen: feet tofeet
Casing length: <u>225</u> feet Casir Screen length: <u>30</u> feet Scree Screen slot size: <u>, 010</u> inches	en diameter: inches Setting depth: From Gravel packed Underreamed Te Other (describe):	Type of casing: Type of screen: feet tofeet lescoped Open hole Natural Development
Casing length: <u>225</u> feet Casin Screen length: <u>20</u> feet Scree Screen slot size: <u>, 010</u> inches Type of completion (circle all applicable)	en diameter: inches Setting depth: From Gravel packed Underreamed Te Other (describe): MAfeet. <u>If telescoped or m</u>	Type of casing: Type of screen: feet tofeet lescoped Open hole Natural Development <u>ore than one screen, describe on next page</u>
Casing length: <u>225</u> feet Casin Screen length: <u>70</u> feet Scree Screen slot size: <u>, 010</u> inches Type of completion (circle all applicable)	en diameter: inches Setting depth: From Gravel packed Underreamed Te Other (describe): MAfeet. If telescoped or m RECE	Type of casing:
Casing length: <u>225</u> feet Casin Screen length: <u>20</u> feet Scree Screen slot size: <u>, 010</u> inches Type of completion (circle all applicable)	en diameter: inches Setting depth: From Gravel packed Underreamed Te Other (describe): MAfeet. If telescoped or m RECE	Type of casing: Type of screen: feet tofeet lescoped Open hole Natural Development <u>ore than one screen, describe on next page</u> Form: Present 3 2008 JUN 1 3
Casing length: <u>225</u> feet Casin Screen length: <u>20</u> feet Scree Screen slot size: <u>, 010</u> inches Type of completion (circle all applicable)	en diameter: inches Setting depth: From Gravel packed Underreamed Te Other (describe): MAfeet. If telescoped or m RECE	Type of casing:

The sketch below only required for water wells

If well telescopes, show depths on sketch. Ground Level_____ <u>Description of formations encountered must be provided for all</u> wells and boreholes, unless specifically exempted by regulations

ound Level	Description of Formations Encountered	From (depth)	To (depth)
	clay dirt.	Ground Level	30
	Georel	30	48
	Blue clay	48	200
	while Sound.	<i></i>	245
		+	1-2-0
		<u> </u>	+
			1

If more than one screen, show location of each on sketch

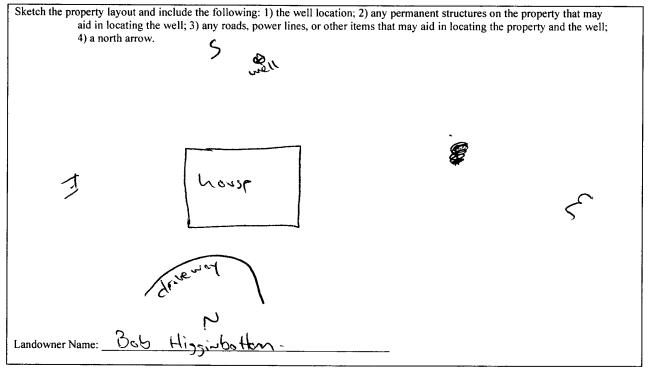

Form: OLWR-SWR-1A

BY: OLWR

I certify that the well/borehole was drilled, constructed, and completed in accordance with all applicable requirements of the Mississippi Department of Environmental Quality and the Mississippi Department of Health regulations, if applicable, and state laws.

RECEIVED Jons W. Man Signature of Licensee Jone, W. Moson 0-620 2-32-08 Print Name of Responsible Licensee and License No. Date JUN 1 3 2008

	STATE WELL REPORT	
County: Des at a	Part 2 Pump Installer's Completion Report	For Office Use Only:
Permit #:	Mississippi Department of Environmental Quality Office of Land and Water Resources	Aquifer:
Driller: Jones w. Mosen	P.O. Box 10631	1 - 120
Date completed: <u>5-17-08</u>	Jackson, MS 39289-0631 (601)961-5210	Well #:/20
Copy information from block on Part 1	(601)354-6938 (fax)	Elevation:

This part of the report must be completed by a licensed water well contractor or a licensed pump installer. A copy of Part 1 of the report must be attached and both parts filed with the Department at the above address within 30 days of well completion.

Well Owner Information		ormation	Well Location		
Owner Name: <u>Bc</u>	nieeih c	botton	Latitude: <u>N34'50.541</u> Longitude: <u>W089'57.24</u>	2	
Mailing Address: 1224 Joybird.		ybird.	Method of Lat/Long (check one): Conventional Survey,		
			USGS quad, Hand-held GPS, Survey-grade GPS		
	ernondo	ms 38632 tate ZipCode	<u>NW 1/2 SW 1/2 Sec 9 T 35 R 7W</u>		
			Distance Direction Nearest Town		
Telephone No. (90)	1) 716-6	414	Miles of Bright		
Ритр Туре		pe	Power Type		
Circle one		e	Circle one		
Air Lift	Jet	Submersible	Diesel Engine Gasoline Engine Natural Gas		
Bucket	Piston	Turbine	Electric Motor Hand Tractor PTO		
Centrifugal	Rotary	Flowing Well	Windmill Other (specify):		
			Horse Power Rating of Motor: 3 - 4p		
Other (specify):			Horse Power Raining of Motor:		

Pump Test Data	Method of Measuring Water Level
Date Well Tested: 5-17-08	Circle one
Static Water Level (A): Feet Below Land Surface	Air Line Electric Measuring Line Steel Tape
Pumping Water Level (B): A Feet Below Land Surface	Other (specify): <u>String (meight</u>
Drawdown $[(B) - (A)]$:Feet Below Land Surface	For flowing well, measured shut in head:feet
Test Pumping Rate: <u>30</u> Gallons Per Minute	Well yielded GPM with a drawdown of
Duration of Pump Test (minimum 4 hours): <u> </u>	$\underline{\mathcal{M}}_{\text{feet after}} \underbrace{\partial \mathcal{H}}_{\text{hours of pumping}}$

Number of Stages: _____

Rated Pump Capacity: <u>30</u> Gallons Per Minute

I HEREBY CERTIFY that the above statements are true to the best of	f my knowledge.		
Jones w Mayor 0-620	Conv. Men.		
Print Name of Pump Installer and License No. (if applicable)	Signature of Pump Installer	DECEN	
			ED

JUN 1 3 2008 BY: OLWR

(4