

STATE WELL REPORT

County: DESOUD
 Permit # _____
 Driller: Bob Smith
 Date drilling completed: 7-7-18

Part I
 Driller's Log
 Mississippi Department of Environmental Quality
 Office of Land and Water Resources
 P.O. Box 2309
 Jackson, MS 39275-2309
 (601)961-5718
 (601)762-5535 (fax)

For Office Use Only:

Well #: L161
 Aquifer: _____
 Ring #: _____

State Law requires that this report be prepared by the license holder responsible for the work and filed with the Department at the above address within 30 days of completion of drilling of the well or borehole.

Well Owner Information <small>(Landowner if borehole is not for a water well)</small>	Well or Borehole Location
Owner Name: <u>PENTAL CONS.</u>	Latitude: <u>34°45'27.29"</u> Longitude: <u>89°58'35.67"</u>
Mailing address: <u>694 Smokestack Dr.</u>	Method of Lat/Long (check one): <input checked="" type="checkbox"/> Conventional Survey
<u>Henrieville MS 38632</u>	USGS quad _____ Hand-held GPS _____ Survey-grade GPS _____
City: _____ State: _____ Zip Code: _____	<u>NW 1/4 NE 1/4, Sec 7 T 4S R 7W</u>
Telephone No. <u>901-517-2044</u>	Miles _____ of _____ (Distance) (Direction) (Nearest Town)

Well / Borehole Data

Date drilling started: 7-7-18 Date drilling completed: 7-7-18 Hole depth: 140 Hole diameter: 8

Location of the source of any surface water used for drilling: _____

Method of casing and volume of Chlorine used in drilling and development: 5 ppm

Logs run (circle all applicable): No log run Electric Gamma Ray Density Sonic Neutron Other: _____

Name of organization running log(s): _____

Purpose of borehole (circle one): Water Well Geotechnical/Geological Investigation Ground Source Heat Pump
 Seismic Survey Other (describe) _____

If drilling is not related to water well construction, skip the remainder of this block

Purpose of Well (circle all applicable): Home Industrial Public Supply Irrigation Fish Culture

Other (describe): _____

If a flowing well, method of flow regulation: Valve _____ Other (describe) _____

Static Water Level: 38 feet above or below land surface Date measured: 7-7-18
(circle one)

Method of measurement (circle one): Steel tape Electric tape Air line Other (describe) _____

Well depth: 140 Well grouted to a depth of: 10 feet Type of grout (circle one): Neat Cement Bentonite Mix

Casing length: 190 feet Casing diameter: 4 inches Type of casing: PVC

Screen length: 10 feet Screen diameter: 4 inches Type of screen: PVC

Screen slot size: 3 THOUS inches Setting depth from 130 feet to 140 feet

Type of completion (circle all applicable): Gravel packed Underreamed Open hole Natural Development

Other (describe): _____

Top of lap pipe or reduction in casing: _____ feet

If telescopic or more than one screen, describe on next page

RECEIVED
 JUL 23 2018
 BY O. WR

STATE WELL REPORT

Part 2

Pump Installer's Completion Report

Mississippi Department of Environmental Quality
Office of Land and Water Resources

P.O. Box 2309
Jackson, MS 39225-2309
(601)961-5210
(601) 360-0535 (fax)

For Office Use Only:

Well #: L161
Aquifer: _____

County: DESOUD
Permit #: _____
Driller: Bob Smith
Date completed: 7-7-18
Copy information from block on Part 1

This part of the report must be completed by a licensed water well contractor or a licensed pump installer. A copy of Part 1 of the report must be attached and both parts filed with the Department at the above address within 30 days of well completion.

Well Owner Information	Well Location
Owner Name: <u>Pentacel Cons.</u>	Latitude: <u>34°45'27.29</u> Longitude: <u>89°58'35.67"</u>
Mailing Address: <u>694 Smokestack Dr.</u>	Method of Lat/Long (check one): Conventional Survey _____ USGS quad _____, Hand-held GPS _____, Survey-grade GPS _____
<u>HEMARD</u> <u>MS</u> <u>38632</u>	<u>NW 1/4 NE 1/4, Sec 7 T 4S R 7W</u>
City State Zip Code	Miles _____ of _____ (Distance) (Direction) (Nearest Town)
Telephone No. <u>(901) 517-2044</u>	

Pump Type (circle one)

Submersible Turbine Air Lift Centrifugal Flowing Well Jet Piston Rotary Other (describe): _____

Date Pump Installed: 7-7-18 Rated Pump Capacity: 22 Gallons Per Minute

Is This Pump (circle one): New Repaired Replacement

Power Type (circle one)

Electric Diesel Gasoline Natural Gas Tractor PTO Windmill Other (describe): _____

Horse Power Rating of Motor: 1 1/2 Setting Depth: 60 feet Number of Stages: 11

Pump Test Data for Non Flowing Well

Date Well Tested: 7-7-18 Duration of Pump Test (minimum 4 hours): _____ hours

Static Water Level (A): 38 Feet Below Land Surface Pumping Water Level (B): _____ Feet Below Land Surface

Drawdown [(B) - (A)]: _____ Feet Below Land Surface Test Pumping Rate: 25 Gallons Per Minute

Method of measurement (circle one): Steel tape Electric tape Airline Other (describe): _____

Pump Test Data for Flowing Well

Measured shut in head: _____ feet

Well yielded _____ GPM with a drawdown of _____ feet after _____ hours of pumping

RECEIVED
JUL 23 2018
BY OLWR

Meter Installation

Meter Manufacturer: _____ Meter Serial Number: _____

Meter Model Number/Name: _____ Type of Meter: _____

Totalizer Register Unit and Multiplier Factor (AF x .001, gal x 1000, etc): _____

Installation Date: _____ Meter installed by: _____

Is This Meter (circle one): New Repaired Replacement

Important: By submitting the above information you are certifying that this meter was installed to manufacturer standards. For agricultural wells, a list of approved meters is on the MDEQ website.

I HEREBY CERTIFY that the above statements are true to the best of my knowledge.

Bob Smith 0645 7-18-18 _____
Print Name of Pump Installer and License No. (if applicable) Date Signature of Pump Installer


County: DESOTO
 Permit #: _____

For Office Use Only:
 Well #: L161

The sketch below only required for water wells

If well telescopes, show depths on sketch.

Ground Level _____

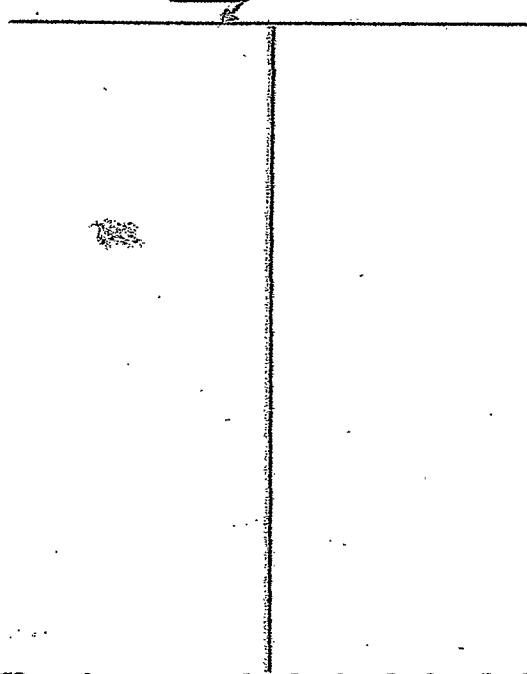


Description of formations encountered must be provided for all wells and boreholes, unless specifically exempted by regulations

Description of Formations Encountered	From (depth) Ground level	To (depth)
TOP SOIL	0	5
REDWATER CLAY	5	22
ONAVEL	22	26
WHITE CLAY	26	108
WHITE SAND	108	140

RECEIVED
 JUL 23 2013
 BY OLWR

If more than one screen, show location of each on sketch

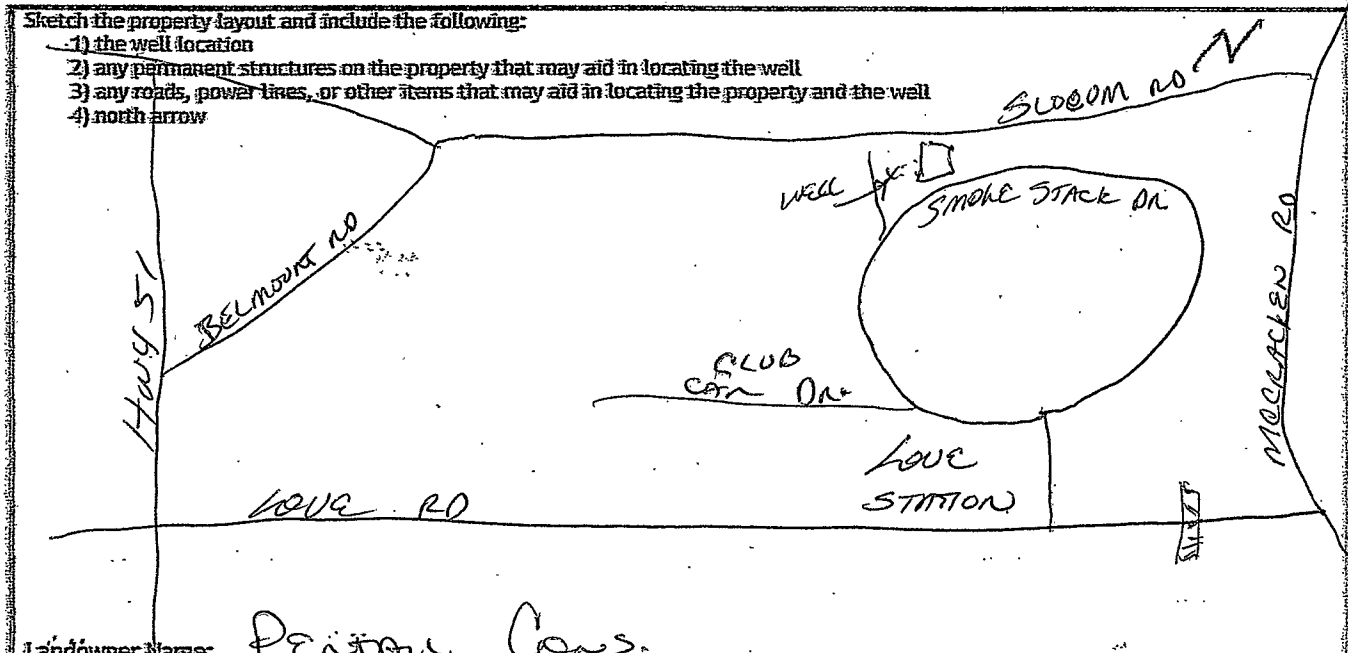

Landowner Name: Peital Cons.

I HEREBY CERTIFY that the well/borehole was drilled, constructed, and completed in accordance with all applicable requirements of the Mississippi Department of Environmental Quality and the Mississippi Department of Health regulations, if applicable, and state laws.

Bob Smith 0645 7-18-18 [Signature]
 Print Name of Responsible Licensee and License No. Date Signature of Licensee