

Desoto MISSISSIPPI BOARD OF WATER COMMISSIONERS

L-302

L
9-23-60


WATER WELL DRILLERS LOG

Date: Sept 23 1960, Driller: Geo. A. Hyde County Desoto
(Name)

(1) Owner of Land:	Description & Color of Materials Sand, Clay, Red Clay, Shell, etc.	Thick- ness Feet	Depth Feet
<u>Bill Brittinhaus</u> (Name)	<u>Top soil</u>	<u>23</u>	
<u>Hernando</u> (Address)	<u>Gravel</u>	<u>30</u>	
(2) Location: <u>1/4</u> , <u>1/4</u> , Sec. <u> </u> T <u> </u> R <u> </u>	<u>Shale of clay</u>	<u>70</u>	
<u>5</u> miles <u>S.E.</u> , of <u>Hernando</u>	<u>Hard sand</u>	<u>32</u>	
(distance) (direction) (Nearest Town)		<u>156 ft</u>	
(3) Topography: <u> </u> (Hilly) <u> </u> (Flat) <u> </u> (Level)	<u>This is all plastic</u>		
(4) Purpose of Well: <u>Domestic</u>	<u>Gravel - wall well</u>		
(Domestic Irrigation Municipal, Industrial, Other)	<u>Beda submersible</u>		
	<u>pump</u>		

Information upon completion of well:

- (1) Diameter 4 inches.
- (2) Total Depth 155 feet.
- (3) Water Level 125 feet below top of ground.
- (4) Cased to , Size .
- (5) Screen: Size 10 slot, Length 6 ft.
- (6) Were any formations sealed against pollution?
 yes, no.

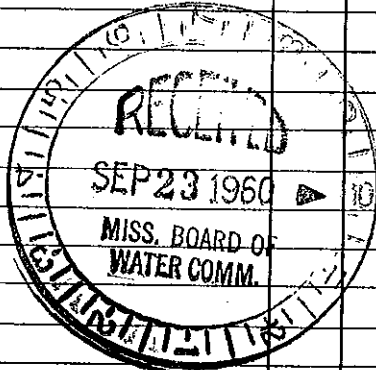

If YES depth of formation

Why

Drillers Remarks:

Well No.

(Use Back Side)

Copy to Board of Water Commissioners 429 Miss. St. Jackson, Miss