

L

L-303

10-16-60

WATER WELL DRILLERS LOG

Date: 10-16, 1960, Driller: A.C. Henderson County Desoto
(Name)

(1) Owner of Land:	Description & Color of Materials Sand, Clay, Red Clay, Shell, etc.	Thick- ness Feet	Depth Feet
<u>William Davis</u> (Name)	<u>Red Clay</u>	<u>30</u>	<u>270</u>
<u>Hernando</u> (Address)	<u>large gravel</u>	<u>30</u>	
(2) Location: <u>1/4</u> , <u>1/4</u> , Sec. <u>24</u> T1R8	<u>white clay</u>	<u>150</u>	
<u>2</u> miles <u>East</u> , of <u>Hernando</u> (distance) (direction) (Nearest Town)	<u>fine sand</u>	<u>60</u>	
(3) Topography: <u>X</u> (Hilly) (Flat) (Level)			
(4) Purpose of Well: <u>Home</u> (Domestic Irrigation Municipal, Industrial, Other)			


Information upon completion of well:

- (1) Diameter 2 inches.
- (2) Total Depth 270 feet.
- (3) Water Level 160 feet below top of ground. # 0052
- (4) Cased to 270, Size 2
- (5) Screen: Size 1/4, Length 6'
90 ga
- (6) Were any formations sealed against pollution?
_____ yes, _____ no.

If YES depth of formation _____

Why _____

Drillers Remarks: _____

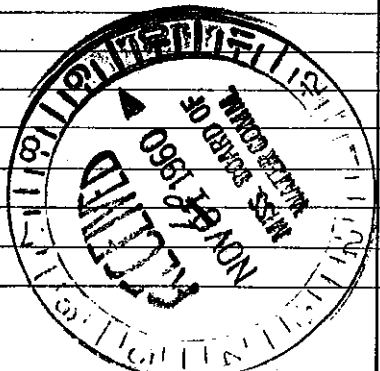

(Use Back Side)

10

Well No.