

Desoto MISSISSIPPI BOARD OF WATER COMMISSIONERS

M 44  
8-3-60

WATER WELL DRILLERS LOG

M-300  
**CODED**

Date: Aug. 3, 19 60, Driller: Deep South Well Co. County Desoto

(Name)

- (1) Owner of Land: G. H. Hawks  
(Name)  
Cockrum, Miss.  
(Address)
- (2) Location: 1/4, 1/4, Sec. 20 T. 3 R. 6,  
10 miles east of Hernando,  
(distance) (direction) (Nearest Town)  
Miss.
- (3) Topography: Hilly  
(Hilly) (Flat) (Level)
- (4) Purpose of Well: Domestic  
(Domestic Irrigation  
Municipal, Industrial, Other)

Description & Color of Materials Sand, Clay, Red Clay, Shell, etc.	Thick- ness Feet	Depth Feet
0-16 Surface Clay	16	
16-60 Red sand, some	44	
60-108 Med. coarse gravel sand	48	

**CODED**


Information upon completion of well:

- (1) Diameter 3 inches.
- (2) Total Depth 108 feet.
- (3) Water Level 46 feet below top of ground.
- (4) Cased to None, Size \_\_\_\_\_
- (5) Screen: Size 2" x .006, Length 6 ft  
slot
- (6) Were any formations sealed against pollution?  
\_\_\_\_\_ yes, No no.

If YES depth of formation \_\_\_\_\_

Why \_\_\_\_\_

Drillers Remarks: None

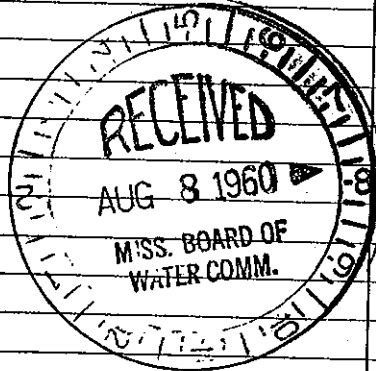

(Use Back Side)

Well No.

Mail this copy to Board of Water Commissioners 429 Miss. St. Jackson, Miss