

M 46

5-22-64

WATER WELL DRILLERS LOG

CODED

Date: 5/22, 1964, Driller: Deep South Well Co. County DeSoto
(Name)

(1) Owner of Land: <u>Billy Freeze</u> <small>(Name)</small> <u>Route 3, Coldwater, Miss.</u> <small>(Address)</small>	Description & Color of Materials Sand, Clay, Red Clay, Shell, etc.	Thick- ness Feet	Depth Feet
	0-20 Surface clay	20	
(2) Location: <u>1/4, 1/4, Sec. 31 32 T 3 R 6,</u> <u>4 miles S.E. of Cockrum</u> <small>(distance) (direction) (Nearest Town)</small>	20-55 Sand & Gravel	35	
	55-80 Fine sand, clay strks.	25	
(3) Topography: <u>Hilly</u> <small>(Hilly) (Flat) (Level)</small>	80-100 Fine sand	20	
	100-119 Coarse & Med. coarse sand	19	
(4) Purpose of Well: <u>Domestic</u> <small>(Domestic Irrigation Municipal, Industrial, Other)</small>			

CODED

Information upon completion of well:

(1) Diameter 2 3/4 inches.

(2) Total Depth 119 feet.

(3) Water Level 84 feet below top of ground.

(4) Cased to None, Size _____


(5) Screen: Size 1 3/8, Length 7 ft

(6) Were any formations sealed against pollution?
 _____ yes, X no.

If YES depth of formation _____

Why _____

Drillers Remarks: _____

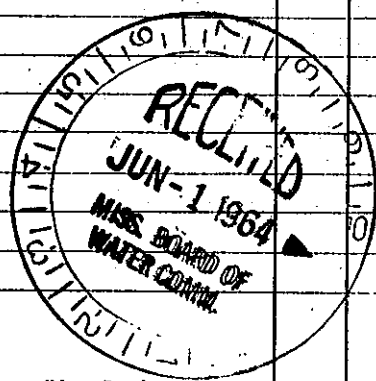

Well No.

(Use Back Side)