

DESOTO MISSISSIPPI BOARD OF WATER COMMISSIONERS

M 47

5-23-65 WATER WELL DRILLERS LOG

CODED

Date: 5-23, 1965, Driller: Harris Bros., County: _____
 (Name)


(1) Owner of Land	Description & Color of Materials Sand, Clay, Red Clay, Shell, etc.	Thick- ness Feet	Depth Feet
<u>Jay R. Sisk</u> (Name) <u>Drogan Mills, Miss</u> (Address)	<u>top soil</u>	<u>0</u>	<u>20</u>
	<u>red sand</u>	<u>20</u>	<u>40</u>
(2) Location: _____ 1/4, _____ 1/4, Sec. <u>19 T 3 R 5</u>	<u>clay & sand</u>	<u>40</u>	<u>80</u>
	<u>coarse sand</u>	<u>80</u>	<u>100</u>
_____ miles _____, of _____ (distance) (direction) (Nearest Town)			
(3) Topography: _____ (Hilly) (Flat) (Level)			
(4) Purpose of Well: <u>domestic</u> (Domestic Irrigation Municipal, Industrial, Other)			

Information upon completion of well:

- (1) Diameter 4 inches.
- (2) Total Depth 100 feet.
- (3) Water Level 60 feet below top of ground.
- (4) Cased to 93', Size 4"
- (5) Screen: Size 4", Length 7'
- (6) Were any formations sealed against pollution?
 _____ yes, _____ no.

CODED

If YES depth of formation _____
 Why _____
 Drillers Remarks: _____

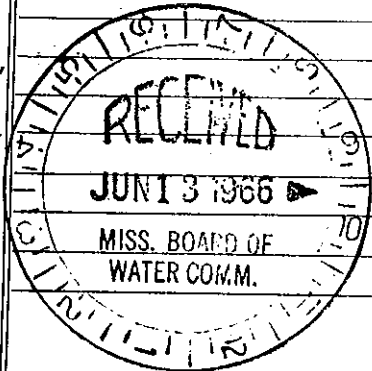

(Use Back Side)

Well No. _____

Mail this copy to Board of Water Commissioners 429 Miss. St. Jackson, Miss