

County: Desoto
 Permit #: _____
 Driller: Jones w. Masov
 Date drilling completed: 11-26-04

Well Driller Report and Well Log

Mississippi Department of Environmental Quality
 Office of Land and Water Resources
 P.O. Box 10631
 Jackson, MS 39289-0631
 (601)961-5210
 (601)354-6938 (fax)

For Office Use Only:
 Aquifer: _____
 Well #: M-142 033
 L. S. Elevation: _____
 E-log #: _____

State Law requires that this report be prepared by the driller in detail and filed with the Department within 30 days of completion of drilling of the well.

Well Owner Information	Well Location
Owner Name: <u>Jodi Dunning</u>	Latitude: <u>34° 46' 56.4"</u> Longitude: <u>89° 49' 49.8"</u>
Mailing Address: <u>5819 Massey rd</u>	Method of Lat/Long (circle one): Conventional Survey, <u>39</u> <u>49</u>
<u>LOT 1</u>	USGS quad: <u>Hand-held GPS</u> , Survey-grade GPS
<u>Colwater</u> MS <u>38618</u>	NE 1/4 SE 1/4 Sec <u>33</u> Twn <u>35</u> Rng <u>6W</u>
City State Zip Code	Distance Direction Nearest Town
Telephone No. <u>(662) 895-0128</u>	<u>1.72</u> Miles <u>SW</u> of <u>Lockport</u>

Well Data

Purpose of Well (circle one) Home Industrial Public Supply Irrigation Fish Culture Other: _____

Date well drilling started: 11-26-04 Date well drilling completed: 11-26-04

If flowing, method of flow regulation: Valve NA Other (describe) _____

Static Water Level: 105 feet above or below (circle one) land surface Date measured: 11-29-04

Method of Measurement (circle one) steel tape electric tape air line other: string weight

Hole depth: 185 Well depth: 175 Well grouted to a depth of 10 feet

Type of grout (circle one): Cement Bentonite Mix

Casing length: 165 feet Casing diameter: 4 inches Type of casing: pvc

Screen length: 10 feet Screen diameter: 4 inches Type of screen: pvc

Screen slot size: .010 inches Setting depth: From 165 feet to 175 feet

Type of completion (circle all applicable): Gravel packed Underreamed Telescoped Open hole Natural Development

Other (describe): _____

Top of lap pipe or reduction in casing: NA feet. If telescoped or more than one screen, describe on back of page

Logs run (circle all applicable): No log run Electric Gamma Ray Density Sonic Neutron Other: _____

Name of organization running log(s): _____

I certify that the well was drilled, constructed, and completed in accordance with all applicable requirements of the Mississippi Department of Environmental Quality and/or the Mississippi Department of Health regulations and state laws.

Jones w. Masov 0-620
 Print Name of Water Well Contractor and License No.

Jones w. Masov
 Signature of Water Well Contractor

If well telescopes please sketch below and show depths.

BY: OLIVER

STATE WELL REPORT

Part 2

Pump Installer's Completion Report
 Mississippi Department of Environmental Quality
 Office of Land and Water Resources
 P.O. Box 10631
 Jackson, MS 39289-0631
 (601)961-5210
 (601)354-6938 (fax)

County: Desoto
 Permit #: _____
 Driller: Jones w. Mason
 Date completed: 11-29-04

For Office Use Only:

Aquifer: _____
 Well #: M-142 33
 Elevation: _____

This report should be prepared by the pump installer in detail and filed with the Department within 30 days of the installation of pump.

Well Owner Information	Well Location
Owner Name: <u>Jodi Dunning</u>	Latitude: <u>34.46.564</u> Longitude: <u>089.49.88</u>
Mailing Address: <u>5819 Massey rd.</u>	Method of Lat/Long (circle one): Conventional Survey,
<u>LOT 1</u>	USGS quad, <u>Hand-held GPS</u> , Survey-grade GPS
<u>Coldwater MS 38618</u>	<u>NE</u> ¼ <u>SE</u> ¼ Sec <u>33</u> Twn <u>3s</u> Rng <u>6w</u>
City State Zip Code	Distance Direction Nearest Town
Telephone No. (<u>601</u>) <u>895-0128</u>	<u>1 1/2</u> Miles <u>SW</u> of <u>Cockrum</u>

Pump Type Circle one	Power Type Circle one
Air Lift Jet <input type="radio"/> <u>Submersible</u> <input checked="" type="radio"/>	Diesel Engine Gasoline Engine Natural Gas
Bucket Piston <input type="radio"/> Turbine <input type="radio"/>	<u>Electric Motor</u> <input checked="" type="radio"/> Hand <input type="radio"/> Tractor PTO <input type="radio"/>
Centrifugal Rotary <input type="radio"/> Flowing Well <input type="radio"/>	Windmill Other (specify): _____
Other (specify): _____	Horse Power Rating of Motor: <u>1 1/2</u>
Date Pump Installed: <u>11-29-04</u>	Setting Depth: <u>130'</u> feet
Rated Pump Capacity: <u>18</u> Gallons Per Minute	Number of Stages: <u>14</u>

Pump Test Data	Method of Measuring Water Level Circle one
Date Well Tested: <u>11-29-04</u>	Air Line Electric Measuring Line Steel Tape
Static Water Level (A): <u>105</u> Feet Below Land Surface	Other (specify): <u>string / weight</u>
Pumping Water Level (B): <u>NA</u> Feet Below Land Surface	For flowing well, measured shut in head: <u>NA</u> feet
Drawdown [(B) - (A)]: <u>NA</u> Feet Below Land Surface	Well yielded <u>18</u> GPM with a drawdown of
Test Pumping Rate: <u>18</u> Gallons Per Minute	<u>NA</u> feet after <u>24</u> hours of pumping
Duration of Pump Test (minimum 4 hours): <u>24</u> hours	

I HEREBY CERTIFY that the above statements are true to the best of my knowledge.

Jones w. Mason 0-620
 Print Name of Pump Installer and License No. (if applicable)

Jones w. Mason
 Signature of Pump Installer

RECEIVED
 NOV 30 2004
 5401WR

033 M-142

topozone



VIEW MAPS | **GET DATA** | **MY TOPOZONE** | **WEB SERVICES** | **ABOUT US**

Map/Photo Info

Topo Download

Photo Download

USGS Topo Maps

1:24K/25K Series

1:100K Series

1:250K Series

Map Size

Small

Medium

Large

View Scale

1 : 50,000

Update Map

Coordinate Format

D/M/S

Coordinate Datum

WGS84/NAD83

Show target

Email this map



Bookmark this map

Print this map

34° 46' 56"N, 89° 50' 21"W (WGS84/NAD83)

USGS Lewisburg Quad

View *TopoZone Pro* aerial photos, shaded relief, street maps, interactive coordinate display, and elevation data

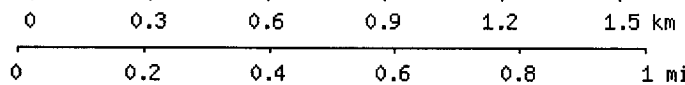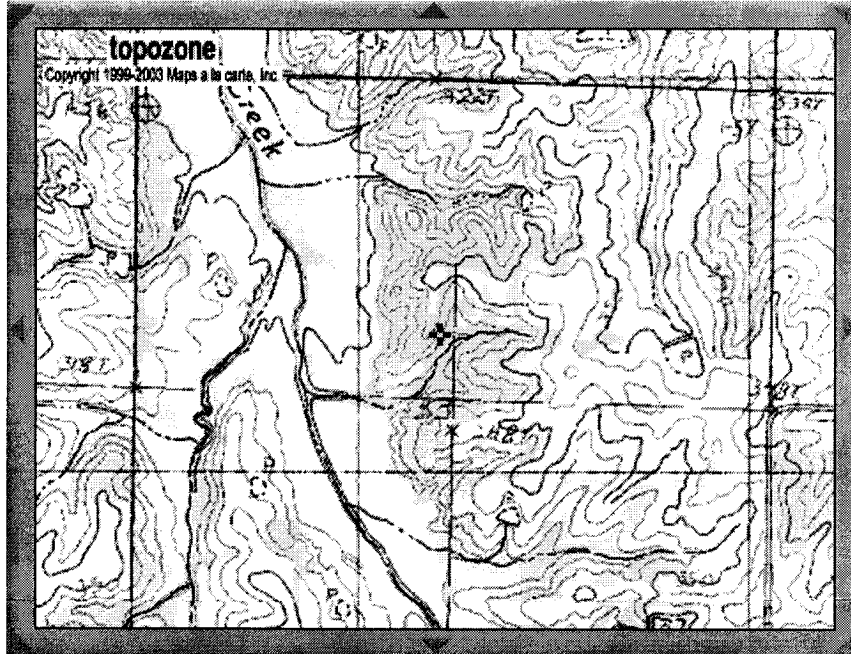

M=-0.111
G=-1.621
What's This?

myTopo.com
GET A CUSTOM MAP PRINT

TopoZone.com © 1999-2004 Maps a la carte, Inc. - All rights reserved.
Use of this site is governed by our Conditions and Terms of Use. We care about your privacy - please read our Privacy Sta