

County: Oesoto  
 Permit #: \_\_\_\_\_  
 Driller: Jones W. Mason  
 Date drilling completed: 11-9-04

### Well Driller Report and Well Log

Mississippi Department of Environmental Quality  
 Office of Land and Water Resources  
 P.O. Box 10631  
 Jackson, MS 39289-0631  
 (601)961-5210  
 (601)354-6938 (fax)

For Office Use Only:  
 Aquifer: \_\_\_\_\_  
 Well #: M-143  
 L. S. Elevation: \_\_\_\_\_  
 E-log #: \_\_\_\_\_

33

State Law requires that this report be prepared by the driller in detail and filed with the Department within 30 days of completion of drilling of the well.

| Well Owner Information  | Well Location  |
|---|--|
| Owner Name: <u>MATT Morgan</u>  | Latitude: <sup>3A</sup> <del>46</del> ° <u>47</u> 38 Longitude: <u>89</u> ° 48 <u>05</u> |
| Mailing Address: <u>10110 hunters walk</u><br><u>fox glenn subdivisions</u> | Method of Lat/Long (circle one): Conventional Survey,                                    |
| <u>heraldo</u> MS <u>38632</u>  | USGS quad, <u>Hand-held GPS</u> , Survey-grade GPS                                       |
| City State Zip Code   | <u>NW SE</u> <u>SE</u> 1/4 <u>NW</u> 1/4 Sec <u>26</u> Tm <u>3S</u> Rng <u>5W</u>        |
| Telephone No. <u>(901) 848-0430</u>   | Distance <u>1.14</u> Miles Direction <u>SE</u> of Nearest Town <u>Cockrum</u>            |

**Well Data**

Purpose of Well (circle one) Home Industrial Public Supply Irrigation Fish Culture Other: \_\_\_\_\_

Date well drilling started: 11-9-04 Date well drilling completed: 11-9-04

If flowing, method of flow regulation: Valve NA Other (describe) \_\_\_\_\_

Static Water Level: 51 feet above or below (circle one) land surface Date measured: 11-15-04

Method of Measurement (circle one) steel tape electric tape air line other: string / weight

Hole depth: 135' Well depth: 135 Well grouted to a depth of 10 feet

Type of grout (circle one): Cement Bentonite Mix

Casing length: 125 feet Casing diameter: 4 inches Type of casing: pvc

Screen length: 10 feet Screen diameter: 4 inches Type of screen: pvc

Screen slot size: .010 inches Setting depth: From 125 feet to 135 feet

Type of completion (circle all applicable): Gravel packed Underreamed Telescoped Open hole Natural Development  
 Other (describe): \_\_\_\_\_

Top of lap pipe or reduction in casing: NA feet. If telescoped or more than one screen, describe on back of page

Logs run (circle all applicable): No log run Electric Gamma Ray Density Sonic Neutron Other: \_\_\_\_\_

Name of organization running log(s): \_\_\_\_\_

I certify that the well was drilled, constructed, and completed in accordance with all applicable requirements of the Mississippi Department of Environmental Quality and/or the Mississippi Department of Health regulations and state laws.

Jones W. Mason 0-620  
 Print Name of Water Well Contractor and License No.

Jones W. Mason  
 Signature of Water Well Contractor

If well telescopes please sketch below and show depths.

RECEIVED  
 DEC 06 2004  
 BY: OLWA


If well telescopes please sketch below and show depths.

| Ground Level |
|--------------|
| M- 148       |
|              |
|              |
| Description of Formations Encountered | From | To  |
|---------------------------------------|------|-----|
| clay dirt.                            | 0    | 10  |
| gravel                                | 10   | 35  |
| white clay                            | 35   | 50  |
| white sand                            | 50   | 135 |
|                                       |      |     |
|                                       |      |     |
If more than one screen, show location of each on sketch

Sketch the property layout and include the following: 1) the well location; 2) any permanent structures on the property that may aid in locating the well; 3) any roads, power lines, or other items that may aid in locating the property and the well; 4) indicate direction.

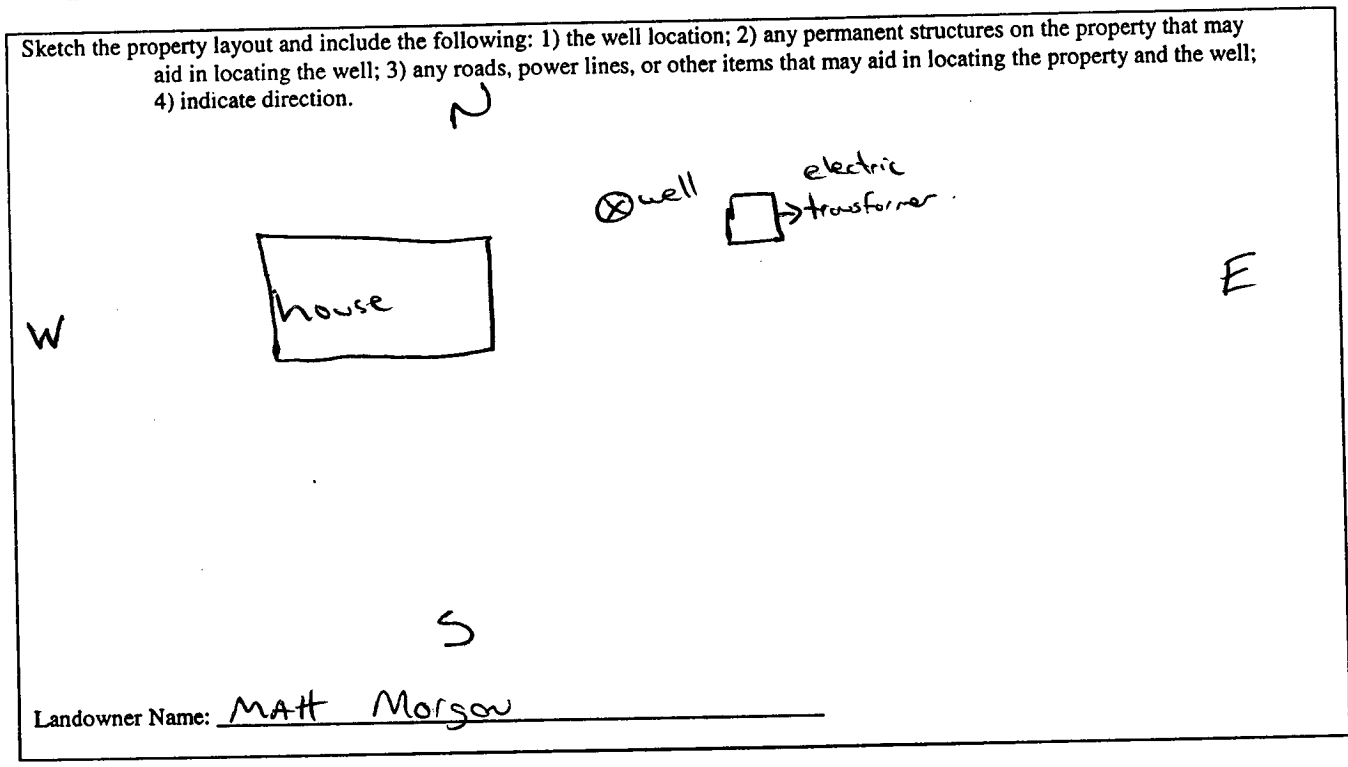

Landowner Name: MATT Morgan

Gas W. Mason  
Signature of Water Well Contractor

RECEIVED  
DEC 08 2004  
BY: OLVA

# STATE WELL REPORT

## Part 2

**Pump Installer's Completion Report**  
 Mississippi Department of Environmental Quality  
 Office of Land and Water Resources  
 P.O. Box 10631  
 Jackson, MS 39289-0631  
 (601)961-5210  
 (601)354-6938 (fax)

For Office Use Only:

Aquifer: \_\_\_\_\_

Well #: M 143 33

Elevation: \_\_\_\_\_

County: Desoto  
 Permit #: \_\_\_\_\_  
 Driller: Jones W Mason  
 Date completed: 11-15-04

This report should be prepared by the pump installer in detail and filed with the Department within 30 days of the installation of pump.

| Well Owner Information  | Well Location   |
|---|---|
| Owner Name: <u>MATT Morgan</u>  | Latitude: <u>46.50.691</u> Longitude: <u>089.48.073</u>   |
| Mailing Address: <u>10110 hunters walk</u><br><u>fox glen subdivision</u> | Method of Lat/Long (circle one): Conventional Survey,<br>USGS quad, <u>Hand-held GPS</u> , Survey-grade GPS |
| <u>herndon ms 38632</u><br>City State Zip Code                            | <u>SE 1/4 NW 1/4 Sec 36 Twn 3S Rng 5W</u>   |
| Telephone No. <u>(901) 848-0430</u>                                       | Distance Direction Nearest Town<br><u>1 1/4</u> Miles <u>SE</u> of <u>Cockrum</u>                           |

| Pump Type<br>Circle one                           | Power Type<br>Circle one                  |
|---|---|
| Air Lift Jet <u>Submersible</u>                   | Diesel Engine Gasoline Engine Natural Gas |
| Bucket Piston Turbine                             | <u>Electric Motor</u> Hand Tractor PTO    |
| Centrifugal Rotary Flowing Well                   | Windmill Other (specify): _____           |
| Other (specify): _____                            | Horse Power Rating of Motor: <u>1 1/2</u> |
| Date Pump Installed: <u>11-15-04</u>              | Setting Depth: <u>100'</u> feet           |
| Rated Pump Capacity: <u>18</u> Gallons Per Minute | Number of Stages: <u>14</u>               |

| Pump Test Data   | Method of Measuring Water Level<br>Circle one            |
|--|--|
| Date Well Tested: <u>11-15-04</u>                          | Air Line Electric Measuring Line Steel Tape              |
| Static Water Level (A): <u>51'</u> Feet Below Land Surface | Other (specify): <u>String / weight</u>                  |
| Pumping Water Level (B): <u>NA</u> Feet Below Land Surface | For flowing well, measured shut in head: <u>N/A</u> feet |
| Drawdown [(B) - (A)]: <u>NA</u> Feet Below Land Surface    | Well yielded <u>18</u> GPM with a drawdown of            |
| Test Pumping Rate: <u>18</u> Gallons Per Minute            | <u>NA</u> feet after <u>24</u> hours of pumping          |
| Duration of Pump Test (minimum 4 hours): <u>24</u> hours   |  |

I HEREBY CERTIFY that the above statements are true to the best of my knowledge.

Jones W Mason Jones W Mason  
 Print Name of Pump Installer and License No. (if applicable) Signature of Pump Installer

RECEIVED  
 11/15/04  
 BY: OLIVER

033 M-143

# topozone



Take this map

- [VIEW MAPS](#)
- [GET DATA](#)
- [MY TOPOZONE](#)
- [WEB SERVICES](#)
- [ABOUT US](#)


- [Map/Photo Info](#)
- [Topo Download](#)
- [Photo Download](#)

46° 51' 09"N, 89° 48' 07"W (WGS84/NAD83)

USGS **Carp River** Quad

View *TopoZone Pro* aerial photos, shaded relief, street maps, interactive coordinate display, and elevation data


- USGS Topo Maps**
- 1:24K/25K Series
  - 1:100K Series
  - 1:250K Series
- Map Size**
- Small
  - Medium
  - Large
- View Scale**
- 1 : 50,000
- [Update Map](#)

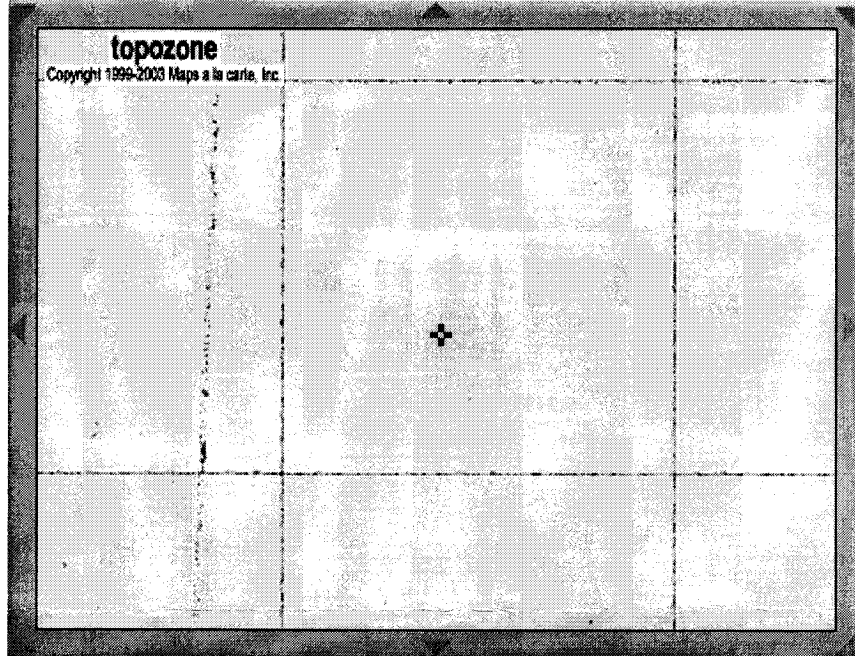

- Coordinate Format**
- D/M/S
- Coordinate Datum**
- WGS84/NAD83
- Show target
- [Email this map](#)
- [Bookmark this map](#)
- [Print this map](#)

myTopo.com

GET A CUSTOM MAP PRINT

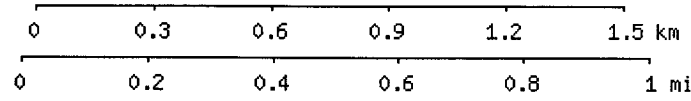

MK

M=-2.209

G=-2.046

What's This?