	State W	/ell Report			
County: Desoto		Driller's Log	For Office Use Only:		
Permit #:		nt of Environmental Quality and Water Resources	Aquifer:		
Driller: Jenes us. Moson.		Box 10631	Well #: <u>M- 188</u>		
Date drilling completed: 5 - 26 - 06		AS 39289-0631	L. S. Elevation:		
Date drilling completed:		961-5210 4-6938 (fax)	E-log #:		
State Law requires that this report Department at the above address					
Information on Well	Owner		orehole Location		
(Landowner if borehole is not f	•	Latitude: 34 . 47,091	" Longitude: 89 . 48 ,337"		
Owner Name Millow Holl Mailing Address: 5180 How		Method of Lat/Long (circle or	" Longitude: <u>89 • 48 ,337</u> " ne): Conventional Survey,		
Maining Address. <u>9100 1104</u>		USGS quad, Hand-held	GPS, Survey-grade GPS		
Hernando			5 Twn 35 Rng Gw		
City Sta	<u>15 38632.</u>				
		Distance Direction	Nearest Town of <u>Geterum</u>		
Telephone No. (901) 384-8006					
	Well / Bore	hole Data			
Date drilling started: 5-36-06. Date dr	illing completed: 5- & - C	Hole depth: 165	Hole diameter: <u>63/4</u>		
Location of the source of any surface wat Method of dosing and volume of Chlorin	er used for drilling: e used in drilling and devel	A lopment: A			
Logs run (circle all applicable) No log ru Name of organization running log(s):A	Electric Gamma Ray	Density Sonic Neutron	Other:		
Purpose of borehole (check one): Water W	ell <u>Geotechnical</u> /Geol	ogical Investigation Ground	d Source Heat Pump		
	SurveyOther (<i>describe</i> <u>to water well construction</u>	e)	lock		
Purpose of Well (check one): Home 🖌	ndustrial Public Supply	/ Irrigation Fish Culture	Other:		
If a flowing well, method of flow regulation	on: Valve <u>^</u> O	other (describe)			
Static Water Level: 100 feet al	pove or below (circle one)	and surface Date measured:	5-30-06		
Method of Measurement (circle one) st	teel tape electric tape	air line other: <u>Str</u>	ing loveight		
Well depth: 165 Well grouted to a de					
Casing length: 155 feet Casin					
Screen length: 10 feet Scre	en diameter: <u> </u>	inches Type of screen:	puc		
Screen slot size: 010 inches	Setting depth: From _	155 feet to [6	feet		
Type of completion (circle all applicable):	Gravel packed Under	reamed Telescoped Open	hole Natural Development		
	Other (describe):	A			
Top of lap pipe or reduction in casing:	NA. feet. If tel	lescoped or more than one scree	en, describe on next page		
	<u> </u>				
			JUN 26 2006		
BY: OLWR					

1

j.

M-188

Description of formations encountered must be provided for all wells and boreholes, unless specifically exempted by regulations


The sketch below only required for water wells

If well telescopes, show depths on sketch. Gr

1

ound Level	Description of Formations Encountered		To (depth)
	clay dirt.	Ground Level	
		40	60
	Growel white sound	60	50
	while clay	90	100
	white sand	100	165
		<u> </u>	
		-	
			1

If more than one screen, show location of each on sketch

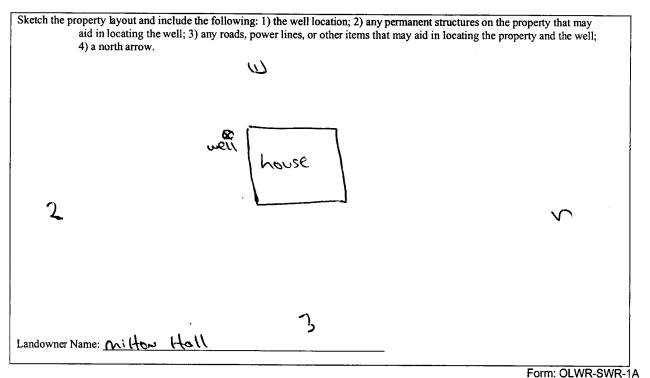

I certify that the well/borehole was drilled, constructed, and completed in accordance with all applicable requirements of the Mississippi Department of Environmental Quality and the Mississippi Department of Health regulations, if applicable, and state laws.

<u>James w. Mosw.</u> 0-600 Print Name of Responsible Licensee and License No. <u>Date</u> Date <u>James w. Mon</u> Signature of Licensee RECEIVED

JUN 26 2006 BY: OLWR

· · · · · · · · · · · · · · · · · · ·	SIAIE WE	LL REPORT	
County: Desuto	Part 2 Pump Installer's Completion Report Mississippi Department of Environmental Quality Office of Land and Water Resources		For Office Use Only:
Permit #:			Aquifer:
Driller: James w-Mosum Date completed: 5-30-06	P.O. H Jackson, M	3ox 10631 1S 39289-0631	Well #: M- 188
Copy information from block on Part 1	(601)961-5210 (601)354-6938 (fax)		Elevation:
This part of the report must be complete report must be attached and both parts	— ed by a licensed water well c filed with the Department a	contractor or a licensed pump i t the above address within 30 d	installer. A copy of Part 1 of the lays of well completion.
Well Owner Information		Well Location	
and the the	1		

Owner Name: Mitton Holl	Latitude: $34.47.091$ Longitude: $89.48.337$			
Mailing Address: 5180 Hung 305	0.5 2.0 Method of Lat/Long (check one): Conventional Survey			
Hernendo MS 38632 City State Zip Code Telephone No. (Sel) 384-8006	USGS quad, Hand-held GPS \checkmark , Survey-grade GPS $N \stackrel{\frown}{=} \frac{13}{4} \stackrel{\frown}{=} \frac{5}{5} \stackrel{\frown}{=} \frac{35}{7} \stackrel{\frown}{=} \frac{35}{7} \stackrel{\frown}{=} \frac{35}{7} \stackrel{\frown}{=} \frac{35}{7} \stackrel{\frown}{=} \frac{35}{7} \stackrel{\frown}{=} \frac{35}{7} \stackrel{\frown}{=} \frac{31}{7} \stackrel{\frown}{=} \frac{5}{7} \stackrel{\frown}{=} \frac{31}{7} \stackrel{\frown}{=} \frac{5}{7} \stackrel{\frown}{=} \frac{31}{7} \stackrel{\frown}{=} \frac{5}{7} \stackrel{\frown}{=} \frac{31}{7} \stackrel{\frown}{=} \frac{5}{7} \stackrel{\frown}{=}$			
Pump Type Circle one	Power Type Circle one			
Air Lift Jet Submersible	Diesel Engine Gasoline Engine Natural Gas			
Bucket Piston Turbine	Electric Motor Hand Tractor PTO			
Centrifugal Rotary Flowing Well	Windmill Other (specify):			
Other (specify):	Horse Power Rating of Motor:			
Date Pump Installed: 5-30-00	Setting Depth: 1 20feet			
Rated Pump Capacity: Gallons Per Minute	Number of Stages: 11			
Pump Test Data	Method of Measuring Water Level Circle one			
Date Well Tested: 5-30-06 Static Water Level (A): Loo Feet Below Land Surface Pumping Water Level (B): Feet Below Land Surface	Air Line Electric Measuring Line Steel Tape Other (specify): <u>5 friws (weight</u>			
Drawdown $[(B) - (A)]: \underbrace{\mathcal{M}^{A}}_{\text{Feet Below Land Surface}}$ Test Pumping Rate: $\underbrace{I \stackrel{\frown}{\partial}}_{\text{Gallons Per Minute}}$ Duration of Pump Test (minimum 4 hours): $\underbrace{\partial \mathcal{H}}_{\text{hours}}$	For flowing well, measured shut in head: $\begin{tabular}{c} \begin{tabular}{c} t$			

I HEREBY CERTIFY that the above statements are true to the best of n	ny kr	nowledge.		
Jones W. Moson.	(Jes w. Man		
Print Name of Pump Installer and License No. (if applicable)	-0	Signature of Pump Installer	DECE	111000
			Form: OLWR	IVED

JUN 2 3 2000 BY: OLWF: