| State Wall Depart | | | | |
|---|---|----------------------|--|--|
| | State Well Report | For Office Use Only: | | |
| County: Desoto | Part 1 – Driller's Log | For Once Use Omy: | | |
| · · · · · · · · · · · · · · · · · · · | Mississippi Department of Environmental Quality | Aquifer: | | |
| Permit #: | Office of Land and Water Resources | Well #: M-214 | | |
| Driller: Jones w. Masons | P.O. Box 10631 | well #: (A_1 | | |
| Dimen: Devel with wides | Jackson, MS 39289-0631 | L. S. Elevation: | | |
| Date drilling completed: $10 - 18 \cdot 66$ | (601)961-5210 | | | |
| | (601)354-6938 (fax) | E-log #: | | |

¥

. .

 State Law requires that this report be prepared by the license holder responsible for the work and filed with the Department at the above address within 30 days of completion of drilling of the well or borehole.

 Information on Well Owner
 Well or Borehole Location

| Information on Well Owner | Well or Borehole Location | | |
|--|---|--|--|
| (Landowner if borehole is not for a water well) | Latitude: 34 • 47 , 944" Longitude: 89 • 50, 942. | | |
| Owner Name Douid Boggs | 37 | | |
| Mailing Address: WT 5 Stephen Henry | Method of Lat/Long (circle one): Conventional Survey, | | |
| maining more constrained and a second second | USGS quad, Hand-held GPS, Survey-grade GPS | | |
| | NE KNW 1/2 Sec 28 Twn 35 Rng 6W | | |
| Herwondo Ms <u>B843Z</u> City State Zip Code | | | |
| • | Distance Direction Nearest Town | | |
| Telephone No. (901) 461-6821 | | | |
| Well / Bore | hole Data | | |
| | | | |
| Date drilling started: $10 - 12 - 06$ Date drilling completed: $10 - 12 - 12$ | | | |
| Location of the source of any surface water used for drilling: | | | |
| | | | |
| Logs run (circle all applicable): No log run Electric Gamma Ray Name of organization running log(s): | Density Sonic Neutron Other: | | |
| Purpose of borehole (check one): Water Well \checkmark Geotechnical/Geol | ogical Investigation Ground Source Heat Pump | | |
| Seismic SurveyOther (describe | 2) | | |
| If drilling is not related to water well construction | n, skip the remainder of this block | | |
| Purpose of Well (check one): Home <u>[]</u> Industrial Public Supply Irrigation Fish Culture Other: | | | |
| If a flowing well, method of flow regulation: Valve $\square \square A$ C | Other (describe) | | |
| Static Water Level: 78 feet above of below (circle one) | | | |
| | | | |
| Method of Measurement (circle one) steel tape electric tape air line other: <u>String (weight</u> | | | |
| Well depth: 140 Well grouted to a depth of 6 feet Type of grout (circle one): Neat Cement Bentonite) Mix | | | |
| Casing length: 130 feet Casing diameter: 4 inches Type of casing: put | | | |
| Screen length: <u>10</u> feet Screen diameter: <u>4</u> inches Type of screen: ρ_{4} | | | |
| Screen slot size: <u>0(0</u> inches Setting depth: From <u>(30</u> feet to <u>(40</u> feet | | | |
| Type of completion (circle all applicable): Gravel packed Underreamed Telescoped Open hole Natural Development | | | |
| Other (describe): | <i>S</i> A | | |
| Top of lap pipe or reduction in casing:feet. If telescoped or more than one screen, describe on next page | | | |
| | Form: OLWR-SWR-1A | | |
| | RECEIVED | | |
| | neveivel | | |

NOV 17 2006 BY: OLWR

N - 214


The sketch below only required for water wells

| If well telescopes, | show | depths | on | <u>sketch</u> . |
|---------------------|------|--------|----|-----------------|
| Ground Level. | | 7 | | |

| <u>oths on sketch</u> . | | | |
|-------------------------|---------------------------------------|--------------|------------|
| | Description of Formations Encountered | From (depth) | To (depth) |
| | cley dirt- | Ground Level | 16 |
| | while soud | 16 | 75 |
| | while class | 75 | 03 |
| | white sound | 28 | 140 |
| | Contra Star | | |
| | | | |
| | | - | |
| | | | |
| | | | |
| | | | |
| | | | |
| 1 | | | |
| | · · · · · · · · · · · · · · · · · · · | | |
| | | | |
| | | | |
| | | | 1 |
| | | | |
| 1 | | | |
| | | | 1 |
| | | | 1 |
| | | | + |
| | L | | <u> </u> |

Description of formations encountered must be provided for all wells and boreholes, unless specifically exempted by regulations

If more than one screen, show location of each on sketch

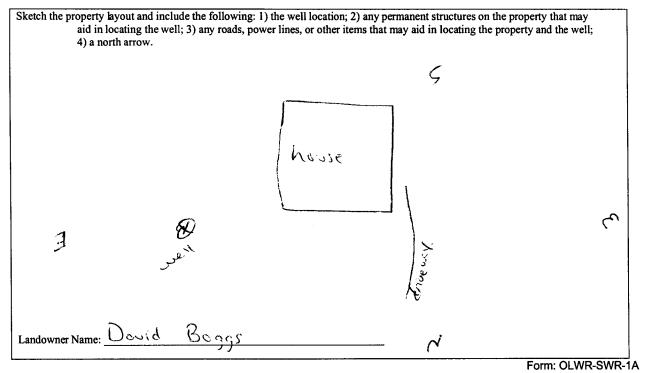

I certify that the well/borehole was drilled, constructed, and completed in accordance with all applicable requirements of the Mississippi Department of Environmental Quality and the Mississippi Department of Health regulations, if applicable, and state laws.

Print Name of Responsible Licensee and License No. Date Signature of Licensee RECEIVED

NOV 1 ? 2006 BY: OLWR

| | STATE WELL REPORT | | | |
|--|--|----------------------|--|--|
| County: Deseto | Part 2 Pump Installer's Completion Report | For Office Use Only: | | |
| Permit #: | Mississippi Department of Environmental Quality | Aquifer: | | |
| Driller: Jones w. Mason | Office of Land and Water Resources P.O. Box 10631 | m Dul | | |
| Date completed: 10-12-06 | Jackson, MS 39289-0631 (601)961-5210 | Well #: | | |
| Copy information from block on Part 1 | (601)354-6938 (fax) | Elevation: | | |
| This part of the report must be completed by a licensed water well contractor or a licensed pump installer. A copy of Part 1 of the report must be attached and both parts filed with the Department at the above address within 30 days of well completion. | | | | |

| Well Owner Information | Well Location | |
|--------------------------------------|--|--|
| Owner Name: David Baggs | Latitude: 34.47.944 Longitude: 89.50, 342 | |
| Mailing Address: LOT 5 Stephen Herry | Method of Lat/Long (check one): Conventional Survey, | |
| | USGS quad, Hand-held GPS, Survey-grade GPS | |
| Herrordo ms | NE 14 NW 1/ Sec 28 T 35 R 6W | |
| City State Zip Code | Distance Direction Nearest Town | |
| Telephone No. (901) 461 - 6821 | 11/2 Miles W of Cockrum | |

| Pump Type Circle one | | Power Type Circle one | | | |
|-------------------------|-------------|--------------------------|--------------------|------------------|-------------|
| Air Lift | Jet | Submersible | Diesel Engine | Gasoline Engine | Natural Gas |
| Bucket | Piston | Turbine | Electric Motor | Hand | Tractor PTO |
| Centrifugal | Rotary | Flowing Well | Windmill | Other (specify): | |
| Other (specify): | | | Horse Power Rating | g of Motor: 3/4 | |
| Date Pump Installe | d: 10-18-06 | | Setting Depth: | 100 | feet |
| Rated Pump Capac | ity: (Ə | Gallons Per Minute | Number of Stages: | ιι | |

| Pump Test Data | Method of Measuring Water Level | | |
|---|---|--|--|
| Date Well Tested: 10-18-06 | Circle one | | |
| Static Water Level (A): 78 Feet Below Land Surface | Air Line Electric Measuring Line Steel Tape Other (specify): <u>String</u> (weight | | |
| Pumping Water Level (B): <u>NA</u> Feet Below Land Surface | | | |
| Drawdown $[(B) - (A)]$: Feet Below Land Surface | For flowing well, measured shut in head: <u>NA</u> feet | | |
| Test Pumping Rate: 12 Gallons Per Minute | Well yielded GPM with a drawdown of | | |
| Duration of Pump Test (minimum 4 hours): $\underline{\partial 4}$ hours | μ feet after $\partial 4$ hours of pumping | | |

| I HEREBY CERTIFY that the above statements are true to the best o | | |
|---|-------------------------------------|-------------------|
| Print Name of Pump Installer and License No. (if applicable) | Signature of Pump Installer | |
| | organitation of a write information | Form: OLWR-SWR-18 |
| | | NOV 17 2006 |
| | | BY: OLWR |