State Well Report				
County: Deroto	Part 1 – Driller's Log	For Office Use Only:		
county:	Mississippi Department of Environmental Quality	Aquifer:		
Permit #:	Office of Land and Water Resources	Well #: M-216		
Driller: Joney w. Mason	P.O. Box 10631	well #:		
	Jackson, MS 39289-0631	L. S. Elevation:		
Date drilling completed: 11-11-06	(601)961-5210			
	(601)354-6938 (fax)	E-log #:		

٤,

7

State Law requires that this report be prepared by the license holder responsible for the work and filed with the Department at the above address within 30 days of completion of drilling of the well or borehole.

Department at the above address matter of days of comp			
Information on Well Owner	Well or Borehole Location		
(Landowner if borehole is not for a water well)	311, 49,010, , , , , , , , , , , , , , , , , ,		
Owner Name Trent Ross	Latitude: $34 \cdot 49 \cdot 010$ , Longitude: $89 \cdot 48 \cdot 746$ , Method of Lat/Long (circle one): Conventional Survey,		
Owner Name	Method of Lat/Long (circle one): Conventional Survey <b>95</b>		
Mailing Address: 3100 Huny 305	Method of LabLong (chefe one). Conventional Survey,		
Maning Madross. <u>J100 (1001 )005</u>	USGS quad, Hand-held GPS, Survey-grade GPS		
	NE 1/ NE 1/2 Sec 22 Twn 35 Rng 6W		
City State Zip Code			
City State Zip Code	Distance Direction Nearest Town		
	Miles N of Cocknom		
Telephone No. (901) 508- 6207			
Well / Bore	ehole Data		
Date drilling started: 11~11~06 Hole depth: 110' Hole diameter: 7''			
	A		
Location of the source of any surface water used for drilling: Method of dosing and volume of Chlorine used in drilling and devel			
Method of dosing and volume of Chlorine used in drilling and deve			
Logs run (circle all applicable): No log run Electric Gamma Ray	Density Sonia Nautron Other		
Name of organization running log(s):	Density Some Neutron Other.		
Purpose of borehole (check one): Water Well / Geotechnical/Geol	ogical Investigation Ground Source Heat Pump		
Seismic Survey Other ( <i>describe</i>	2)		
If drilling is not related to water well construction, skip the remainder of this block			
Purpose of Well (check one): Home 🗹 Industrial Public Supply Irrigation Fish Culture Other:			
If a flowing well, method of flow regulation: Valve Other (describe)			
State Water Long 30 State ( ) 110 State ( ) 110 State ( )			
Static Water Level: <u>30</u> feet above or below (circle one) land surface Date measured: <u>11~15~06</u>			
Method of Measurement (circle one) steel tape electric tape air line other: String weight			
Method of Measurement (circle one) steel tape electric tape all time other: <u>Sty ine (see ign)</u>			
Well depth: <u>110</u> Well grouted to a depth of <u>10</u> feet Type of grout (circle one): Neat Cement Bentonite Mix			
Casing length: 100 feet Casing diameter: 4 inches Type of casing: puc			
р с с <u>—</u>			
Screen length: 10 feet Screen diameter: 4 inches Type of screen: 000			
Screen slot size: <u>, <b>()</b></u> inches Setting depth: From	feet to feet		
Type of completion (circle all applicable) Gravel packed Underreamed Telescoped Open hole Natural Development			
Type of completion (circle all applicable) Gravel packed Under	rreamed Telescoped Open hole Natural Development		
Other (describe):			
Other (describe):A			
Top of lap pipe or reduction in casing:feet. If telescoped or more than one screen, describe on next page			
Top of the pipe of found in an outsing.			
Form: OLWR-SWR-1			

DEC 0 5 2006 BY: OLWR


M-216

## The sketch below only required for water wells

Description of formations encountered must be provided for all wells and boreholes, unless specifically exempted by regulations

Ground Level	Description of Formations Encountered From (depth) Clay diff Ground Level	To (depth 30
	white clay 30	36
	while said 36	110
		+
		+
		-
		+

If more than one screen, show location of each on sketch

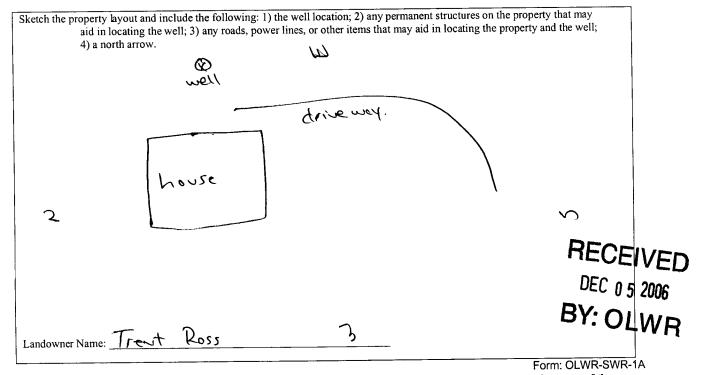

I certify that the well/borehole was drilled, constructed, and completed in accordance with all applicable requirements of the Mississippi Department of Environmental Quality and the Mississippi Department of Health regulations, if applicable, and state

laws.

 Janes w. Master
 0-620
 11-29-06
 Jens w. Master

 Print Name of Responsible Licensee and License No.
 Date
 Signature of Licensee

Print Name of Responsible Licensee and License No.

ŧ

STATE WELL REPORT				
County:DesstoPPermit #:Pump Installer'sDriller:Janes w- MasonDate completed:11-15-06Good and a statementGood and a statementCounty:12-15-06County:Good and a statementCounty:12-15-06County:Good and a statementCounty:12-15-06County:Good and a statementCounty:12-15-06County:12-15-06County:12-15-06County:12-15-06	art 2         a Completion Report         it of Environmental Quality         ind Water Resources         30x 10631         1S 39289-0631         961-5210         4-6938 (fax)         contractor or a licensed pump installer. A copy of Part 1 of the			
<u>النع کی اللہ اللہ 38654</u> <u>City</u> <u>State</u> Zip Code Telephone No. ( <b>101</b> ) <u>508- 6207</u>	USGS quad, Hand-held GPS $\checkmark$ , Survey-grade GPS $\underline{NE}$ $\underline{NE}$			
Pump Type Circle one	Power Type Circle one			
Air Lift Jet Submersible	Diesel Engine Gasoline Engine Natural Gas			
Bucket Piston Turbine	Electric Moto Hand Tractor PTO			
Centrifugal Rotary Flowing Well	Windmill   Other (specify):			
Other (specify):	Horse Power Rating of Motor:3/4			
Date Pump Installed:   12-06     Rated Pump Capacity:   12   Gallons Per Minute	Setting Depth:feet Number of Stages:			
Pump Test Data         Date Well Tested:       1 \n \ 5 - \orage C         Static Water Level (A):       30         Feet Below Land Surface         Pumping Water Level (B):       NA         Feet Below Land Surface	Method of Measuring Water Level Circle one Air Line Electric Measuring Line Steel Tape Other (specify): <u>String (meight</u>			
Pumping Watch Deter (b):       rest Deter Solow Data Surface         Drawdown [(B) – (A)]: $\swarrow^A$ Feet Below Land Surface         Test Pumping Rate:       [] $\bigcirc^A$ Gallons Per Minute         Duration of Pump Test (minimum 4 hours): $\bigcirc^A$ hours	For flowing well, measured shut in head: <u>M</u> feet Well yielded <u>12</u> GPM with a drawdown of <u>M</u> feet after <u>24</u> hours of pumping <b>RECEIVED</b>			
I HEREBY CERTIFY that the above statements are true to the best of my knowledge.				
Jones W. Mason 0-620	Signature of Pump Installer BY: OLWR			
Print Name of Pump Installer and License No. (if applicable) / Signature of Pump Installer Form: OLWR-SWR-1B				

•-

¥.