State Well Report				
County: Desato	Part 1 – Driller's Log	For Office Use Only:		
	Mississippi Department of Environmental Quality	Aquifer:		
Permit #:	Office of Land and Water Resources	Well #: M-231		
Driller: Jones w. Moson.	P.O. Box 10631			
Dimer Denes C. Wesser	Jackson, MS 39289-0631	L. S. Elevation:		
Date drilling completed: 5-33-07	(601)961-5210			
	(601)354-6938 (fax)	E-log #:		

١ŧ

State Law requires that this report be prepared by the license holder responsible for the work and filed with the Department at the above address within 30 days of completion of drilling of the well or borehole.


Information on Well Owner	Well or Borehole Location		
(Landowner if borehole is not for a water well)	24 40 (4) 80 118 787		
	Latitude: <u>34 ° 48</u> , <u>641</u> " Longitude: <u>89 ° 48 , 38</u> , <u>39</u> Method of Lat/Long (circle one): Conventional Survey,		
Owner Name Jerry Melton	Method of Lat/Long (circle one): Conventional Survey		
Mailing Address: 10435. N. Cockinn form rol.	USGS quad, Hand-held GPS, Survey-grade GPS		
Hernondo Ms. 38632. City State Zip Code	SE 4NW 4 Sec 23 Twn 35 Rng 6W		
City State Zip Code	Distance Direction Nearest Town		
Telephone No. (62) 229-6957	12 Miles NE of Coctor		
Telephone No. $(37) 237 6737$			
Well / Bore	hole Data		
Date drilling started: $5^{-}3^{-}$ Date drilling completed: $5^{-}3^{-}$	\bigcirc Hole depth: <u>135</u> Hole diameter: <u>6314</u>		
Location of the source of any surface water used for drilling:	<u> </u>		
Method of dosing and volume of Chlorine used in drilling and devel	opment: <u>M</u>		
Logs run (circle all applicable). No log run Electric Gamma Ray Density Sonic Neutron Other:			
Purpose of borehole (check one): Water Well <u>Geotechnical/Geological Investigation</u> Ground Source Heat Pump			
Seismic Survey Other (describe) If drilling is not related to water well construction, skip the remainder of this block			
Purpose of Well (check one): HomeIndustrial Public Supply Irrigation Fish Culture Other:			
If a flowing well, method of flow regulation: Valve C	Other (describe)		
Static Water Level: <u>30</u> feet above or felow (circle one) land surface Date measured: <u>5-35-07</u>			
Method of Measurement (circle one) steel tape electric tape	air line other: String Leight		
Well depth: $125'$ Well grouted to a depth of <u>10</u> feet Type of grout (circle one): Neat Cement Bentonite Mix			
Casing length: <u>115</u> feet Casing diameter: <u>4</u> inches Type of casing: <u>pvc</u>			
Screen length: 19 feet Screen diameter: 9			
Screen slot size: 100 inches Setting depth: From 15 feet to 125 feet			
Type of completion (circle all applicable): Gravel packed Underreamed Telescoped Open hole Natural Development			
Other (describe):			
Top of lap pipe or reduction in casing: <u>MA</u> feet. <u>If telescoped or more than one screen, describe on next page</u>			
	Form: OLWR-SWR-1A		

M-231

The sketch below only required for water wells

If well telescopes,	show	depths	on	sketch.
Ground Level.		7		

Description of formations encountered must be provided for all wells and boreholes, unless specifically exempted by regulations				
	Description of Formations Encountered	From (depth)	To (depth)	
	clay dirt.	Ground Level	15	
	while clay	15	35	
	cultite schoi	35	75	
	white day	- 75	001	
	white send.	100	125	

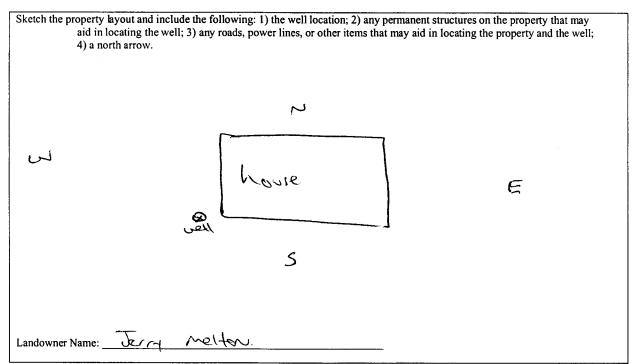

Form: OLWR-SWR-1A

I certify that the well/borehole was drilled, constructed, and completed in accordance with all applicable requirements of the Mississippi Department of Environmental Quality and the Mississippi Department of Health regulations, if applicable, and state laws.

Jowey + MayonG-(P-07).Grow.Print Name of Responsible Licensee and License No.DateSignature of Licensee

STATE WELL REFORT				
County: Desoto	Part 2 Pump Installer's Completion Report	For Office Use Only:		
Permit #:	Mississippi Department of Environmental Quality	Aquifer:		
Driller: Jone's w. Moscul	Office of Land and Water Resources P.O. Box 10631	m 221		
Date completed: 5- 75-07	Jackson, MS 39289-0631 (601)961-5210	Well #: <u>M-23</u>		
Copy information from block on Part 1	(601)354-6938 (fax)	Elevation:		

This part of the report must be completed by a licensed water well contractor or a licensed pump installer. A copy of Part 1 of the report must be attached and both parts filed with the Department at the above address within 30 days of well completion.

Well Owner Information	Well Location	
Owner Name: Jerry Melton	Latitude: 34, 48, 641 Longitude: 89-48 287	
Mailing Address: 10435. N. Carleron form N.	Method of Lat/Long (check one): Conventional Survey,	
	USGS quad, Hand-held GPS, Survey-grade GPS	
City State Zip Code	SE 1/NW 1/ Sec 23 T 35 RGW	
	Distance Direction Nearest Town	
Telephone No. (62) 229-6957	12 Miles NE of Cockerum.	

Pump Type Circle one		Power Type Circle one			
Air Lift	Jet	Submersible	Diesel Engine	Gasoline Engine	Natural Gas
Bucket	Piston	Turbine	Electric Motor	Hand	Tractor PTO
Centrifugal	Rotary	Flowing Well	Windmill	Other (specify):	
Other (specify):			Horse Power Rating	of Motor: 314	
Date Pump Installed:	5-35-0	<u>م</u>	Setting Depth:	60	feet
Rated Pump Capacity	: 12-	Gallons Per Minute	Number of Stages: _	11	

Pump Test Data	Method of Measuring Water Level Circle one		
Date Well Tested: 5-35-07			
Static Water Level (A):Feet Below Land Surface	Air Line Electric Measuring Line Steel Tape		
Pumping Water Level (B):Feet Below Land Surface	Other (specify): String (veight		
محمم Feet Below Land Surface	For flowing well, measured shut in head:feet		
Test Pumping Rate: Gallons Per Minute	Well yielded GPM with a drawdown of		
Duration of Pump Test (minimum 4 hours): <u>$\partial \nu$</u> hours	feet afterhours of pumping		

I HEREBY CERTIFY that the above statements are true to the best of my knowledge.			
Jees v. Meson 0-620	Georg V. Man		
Print Name of Pump Installer and License No. (if applicable)	Signature of Pump Installer		
		EARNER OLIVID OWND 4D	

STATE WELL REPORT

.

.

Form: OLWR-SWR-1B