State V	Vell Report	
	Driller's Log For Office Use Only:	
Mississimi Densita	nt of Environmental Quality Aquifer:	
	and Water Resources Box 10621 Well #: M-237	
Jackson, r	MS 39289-0631 L. S. Elevation:	
)961-5210 54-6938 (fax) E-log #:	
State Law requires that this report be prepared by the lice Department at the above address within 30 days of com	cense holder responsible for the work and filed with the pletion of drilling of the well or borehole.	
Information on Well Owner	Well or Borehole Location	
(Landowner if borehole is not for a water well)	34,42,391, 20,00,00,00,00,00	
Owner Name Chuck Childers.	Latitude:	
Mailing Address: LOT 22	Latitude: $34 \cdot 47 \cdot 391$ "Longitude: $89 \cdot 48 \cdot 117$ " 23 Method of Lat/Long (circle one): Conventional Survey,	
Fox Glen Subdivision	USGS quad, Hand-held GPS Survey-grade GPS	
	JE 1/ SW 1/4 Sec_ 26 Twn 35 Rng 6W	
Hernondo Ms. 38632 City State Zip Code		
	Distance Direction Nearest Town 14 Miles SE of OCECON	
Telephone No. (<u> </u>		
Well / Bord	hala Data	
Date drilling started: 6-13-07 Date drilling completed: 6-13-	Mole depth: 140 Hole diameter: 6314	
Location of the source of any surface water used for drilling:		
Method of dosing and volume of Chlorine used in drilling and deve	Ionment:	
Logs run (circle all applicable). No log rup Electric Gamma Ray Name of organization running log(s):	Density Sonic Neutron Other:	
Purpose of borehole (check one): Water Well \checkmark Geotechnical/Geol	ogical Investigation Ground Source Heat Pump	
Seismic Survey Other (describe	2)	
If drilling is not related to water well construction	n, skip the remainder of this block	
Purpose of Well (check one): Home <u>Industrial</u> Public Supply	Irrigation Fish Culture Other:	
If a flowing well, method of flow regulation: Valve C		
Static Water Level: <u><u>90</u> feet above of below (circle one)</u>		
	air line other: <u>String lueight</u>	
Well depth: <u>(40)</u> Well grouted to a depth of <u>(0)</u> feet Type		
Casing length: 130 feet Casing diameter: 4	inches Type of casing:	
Screen length: 10 feet Screen diameter: 4	_inches Type of screen:	
Screen slot size:, 010 inches Setting depth: From	130 feet to 140 feet	
Type of completion (circle all applicable): Gravel packed Under	reamed Telescoped Open hole Natural Development	
Other (describe):		
Top of lap pipe or reduction in casing: <u>MA</u> feet. If tel		

£

*

Form: OLWR-SWR-1A

JUL 1 3 2007 BY: OLWR

M-237

To (depth)

30 45

08

1 10

140

Description of formations encountered must be provided for all wells and boreholes, unless specifically exempted by regulations

From (depth)

<u>30</u> <u>45</u>

Ground Level


08

110


The sketch below only required for water wells

If well telescopes, show depths on sketch. Ground Level

Ţ

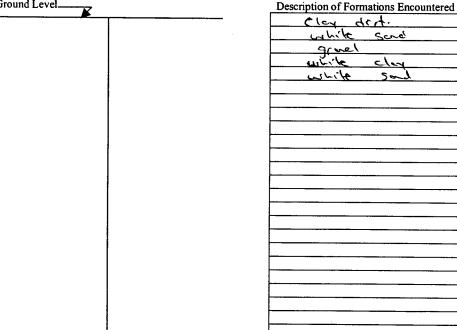

If more than one screen, show location of each on sketch

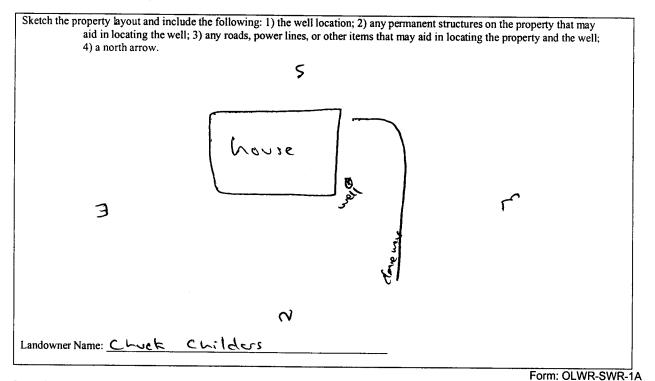

I certify that the well/borehole was drilled, constructed, and completed in accordance with all applicable requirements of the Mississippi Department of Environmental Quality and the Mississippi Department of Health regulations, if applicable, and state

Date

laws. Jores 0-620 w. Meson 2-10-07

Print Name of Responsible Licensee and License No.

Signature of Licensee

JUL 1 3 2007 BY: OLWR

RECEIVED

	STATE WELL REPORT	
County: Desato	Part 2 Pump Installer's Completion Report	For Office Use Only:
Permit #:	Mississippi Department of Environmental Quality Office of Land and Water Resources	Aquifer:
Driller: Jones w. Mason Date completed: 6-16-07	P.O. Box 10631 Jackson, MS 39289-0631	Well #: M- 237
Copy information from block on Part 1	(601)961-5210 (601)354-6938 (fax)	Elevation:
This part of the report must be complete report must be attached and both parts j		installer. A copy of Part 1 of the days of well completion.

Well Owner Information	Well Location		
Owner Name: Chuck Childers	Latitude: 34, 47, 391 Longitude: 89, 48, 117		
Mailing Address: LOT 22	Method of Lat/Long (check one): Conventional Survey,		
fox Glen. Subdivision	USGS quad, Hand-held GPS 🖌, Survey-grade GPS		
Herrodo M3 38632 City State Zip Code	<u>SE 1/ SW 1/4 Sec 26 T 35 R 6W</u>		
	Distance Direction Nearest Town		
Telephone No. (⁹) 27 - 5213	14 Miles SE of Cockrum,		
Ритр Туре	D		
Circle one	Power Type Circle one		
Air Lift Jet Submersible	Diesel Engine Gasoline Engine Natural Gas		
Bucket Piston Turbine	Electric Motor Hand Tractor PTO		
Centrifugal Rotary Flowing Well	Windmill Other (specify):		
Other (specify):	Horse Power Rating of Motor: 3/4		
Date Pump Installed: 6 - 16 - 07	Setting Depth: l 1 0feet		
Rated Pump Capacity: Gallons Per Minute	Number of Stages: l l		

Pump Test Data	Method of Measuring Water Level
Date Well Tested: 6-16-07	Circle one
Static Water Level (A): 90 Feet Below Land Surface	Air Line Electric Measuring Line Steel Tape
Pumping Water Level (B): <u>NA</u> Feet Below Land Surface	Other (specify): <u>String (weight</u>
Drawdown [(B) – (A)]:Feet Below Land Surface	For flowing well, measured shut in head:
Test Pumping Rate: (2 Gallons Per Minute	Well yielded GPM with a drawdown of
Duration of Pump Test (minimum 4 hours): <u>24</u> hours	<u></u> feet after <u>24</u> hours of pumping

I HEREBY CERTIFY that the above statements are true to the best	of my knowledge.	
Jones W. Meson 0-620	game w. More	
Print Name of Pump Installer and License No. (if applicable)	Signature of Pump Installer	
	FormPECEIAE	D

F

JUL 1 3 2007 BY: OLW R