	State Well Report	
County: Desoto	Part 1 – Driller's Log	For Office Use Only:
	sippi Department of Environmental Quality	Aquifer:
Permit #:	Office of Land and Water Resources	Well #: M-257
Driller: Jones W- Mason	P.O. Box 10631	
Date drilling completed: 12-11-07	Jackson, MS 39289-0631 (601)961-5210	L. S. Elevation:
	(601)354-6938 (fax)	E-log #:
State Law requires that this report be pre Department at the above address within .	pared by the license holder responsible for a 30 days of completion of drilling of the well	the work and filed with the
Information on Well Owner	Well or Bo	rehole Location
(Landowner if borehole is not for a wate	r well)	89.42.79r
Owner Name Showa Thompson	Method of Lat/Long (circle or	" Longitude: <u>87 • 43</u> , 795" He): Conventional Survey,
Mailing Address: 5395 longston		GPS, Survey-grade GPS
RIN		Twn 35 Rng Sw
Byholia MS City State	Zip Code Distance Direction	Nearest Town of ingrans Mill
Telephone No. (101) 486 - 3172	Miles <u>&gt;</u> E	of Ingrans Mill
	Well / Borehole Data	
Date drilling started: $(2-11.27)$ Date drilling com Location of the source of any surface water used for	r drilling:	Hole diameter: <u>6<sup>3</sup>/4</u>
Method of dosing and volume of Chlorine used in	drilling and development: M	
Logs run (circle all applicable): No log run Electrication running log(s):	ic Gamma Ray Density Sonic Neutron	Other:
Purpose of borehole (check one): Water Well	eotechnical/Geological Investigation Ground	Source Heat Pump
Seismic Survey	Other (describe)	ark
Purpose of Well (check one): Home <u>Industrial</u>		
If a flowing well, method of flow regulation: Valve Other (describe)		
Static Water Level: 40 feet above or be		
Method of Measurement (circle one) steel tape	electric tape air line other: stri	glineight.
Well depth: 135 Well grouted to a depth of		
Casing length: <u>115</u> feet Casing diameter	er: <u> </u>	pul
Screen length: <u>(0</u> feet Screen diamete		
Screen slot size: <u>010</u> inches Setting		
Type of completion (circle all applicable): Gravel p		nole Natural Development
Other (o	describe):	
Top of lap pipe or reduction in casing:	feet. If telescoped or more than one scree	n, describe on next page

Form: OLWR-SWR-1A


## The sketch below only required for water wells

If well telescopes, show depths on sketch. Ground Level\_

Description of formations encountered must be provided for all wells and boreholes, unless specifically exempted by regulations

Description of Formations Encountered	From (depth) Ground Level	10
grael	15	38
white clay	30	4
white soud	45	12
		1
		1
		1
·····		

If more than one screen, show location of each on sketch

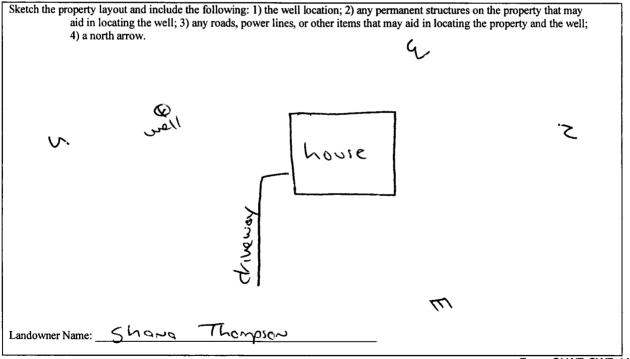

Form: OLWR-SWR-1A

I certify that the well/borehole was drilled, constructed, and completed in accordance with all applicable requirements of the Mississippi Department of Environmental Quality and the Mississippi Department of Health regulations, if applicable, and state

laws. Torres W. Mosco 0-670 -1-9-08 Jour Mon Int Name of Responsible Licensee and License No. Date Signature of Licensee

Print Name of Responsible Licensee and License No.

and a second An and a second secon

	STATE WELL REPORT	
County: Des oto	Part 2 Pump Installer's Completion Report	For Office Use Only:
Permit #:	Mississippi Department of Environmental Quality	Aquifer:
Driller: Jones W. Mason	Office of Land and Water Resources P.O. Box 10631	well #: 11-253
Date completed: 12-14-07	Jackson, MS 39289-0631 (601)961-5210	
Copy information from block on Part 1	(601)354-6938 (fax)	Elevation:
This part of the report must be completed	l by a licensed water well contractor or a licensed pump	installer. A copy of Part 1 of the

report must be attached and both parts filed with the Department at the above address within 30 days of well completion.					
Well Owner Information		Well Location			
Owner Name: <u>Sho</u>	No Tho.	MOSON	Latitude: 34, 46	.832 Longitude:	9.43.795
Mailing Address: 5395 longston rd.		Method of Lat/Long (check one): Conventional Survey,			
		USGS quad, Hand-held GPSSurvey-grade GPS			
Byt	<u>state</u>	<u>S 38611</u> Zip Code	SW KNE K	4 Sec 33 T 35	R Swi
City	State		Distance D	irection Nearest	Гown
Telephone No. (901)	486-31	72	<u>3</u> Miles <u>3</u>	E of ingrow	s mill
	Pump Type Circle one			Power Type Circle one	
Air Lift	<b>.</b>	$\sim$			
	Jet	Submersible	Diesel Engine	Gasoline Engine	Natural Gas
Bucket	Jet Piston	Submersible Turbine	Diesel Engine Electric Motor	Gasoline Engine Hand	Natural Gas Tractor PTO
				U	Tractor PTO
Bucket	Piston Rotary	Turbine	Electric Motor Windmill	Hand Other (specify):	Tractor PTO
Bucket Centrifugal	Piston Rotary	Turbine Flowing Well	Electric Motor Windmill Horse Power Rating	Hand	Tractor PTO

Pump Test Data	Method of Measuring Water Level Circle one	
Date Well Tested:       ()       ()       ()         Static Water Level (A):        Feet Below Land Surface         Pumping Water Level (B):        Feet Below Land Surface	Air Line Electric Measuring Line Steel Tape Other (specify): <u>String Lineight</u>	
Drawdown [(B) – (A)]:Feet Below Land Surface	For flowing well, measured shut in head:	
Test Pumping Rate: Gallons Per Minute	Well yieldedGPM with a drawdown of	
Duration of Pump Test (minimum 4 hours): $\underline{\partial \Upsilon}$ hours	hours of pumping	

I HEREBY CERTIFY that the above statements are true to the best o	f my knowledge.	
Print Name of Pump Installer and License No. (if applicable)	Signature of Pump Installer	
		Form: OLWR-SWR-1B

BY OLAR